





**NORTH ELEVATION**



**SOUTH ELEVATION**



**EAST ELEVATION**



**WEST ELEVATION**

**ELEVATIONS**

**OVERALL BUILDING DIMENSIONS**

<b>NORTH ELEVATION</b>	
LENGTH: 97'	HEIGHT: 26'-9"
<b>SOUTH ELEVATION</b>	
LENGTH: 97'	HEIGHT: 26'-9"
<b>EAST ELEVATION</b>	
LENGTH: 78'	HEIGHT: 26'-9"
<b>WEST ELEVATION</b>	
LENGTH: 78'	HEIGHT: 26'-9"

**OVERALL LOT FRONTAGE DIMENSIONS**

<b>NORTH ELEVATION</b>	
LENGTH: 573'	
<b>SOUTH ELEVATION</b>	
LENGTH: 736'	
<b>EAST ELEVATION</b>	
LENGTH: 524'	
<b>WEST ELEVATION</b>	
LENGTH: 341'	



  
 1001 EXECUTIVE PARK DR.  
 SUITE 2000  
 KNOXVILLE, TN 37922  
 OFFICE 615-583-8001  
 FAX 615-583-0881  
 WWW.LINKSCORP.COM


PROJECT SCOPE: EXISTING FACILITY RE-BRAND - OH100488  
 LOCATION: DUBLIN OHAWILL  
 ARCHITECT: FTCO  
 CITY, STATE, ZIP: DUBLIN OH 43017  
 PROJECT #: 11-0188  
 DRAWN BY: BL  
 DATE:

REV	DATE	DESCRIPTION OF REVISION
08/01/11		Approved per client
08/23/11		Relocate Sign A, B, C, D and Sign K - 0 per clients request
05/28/11		Relocate Sign A, B, C, D and Sign K - 0 per clients request

BY	DATE	REMARK - APPROVAL TYPE	STATUS	BY
08/01/11		CLEAR FINAL APPROVAL	APPROVED	FWH/Thal Bank - JJ
08/01/11		LOCAL JURISDICTION PRELIMINARY APPROVAL	APPROVED	
08/01/11		COSWELL PRELIMINARY APPROVAL	APPROVED	
08/01/11		CLEAR PRELIMINARY APPROVAL	APPROVED	FWH/Thal Bank - JJ

**APPROVED**  
LINK & HARRINGTON, LLC  
08-08-11

**PROPOSED SIGNAGE SITE PLAN**

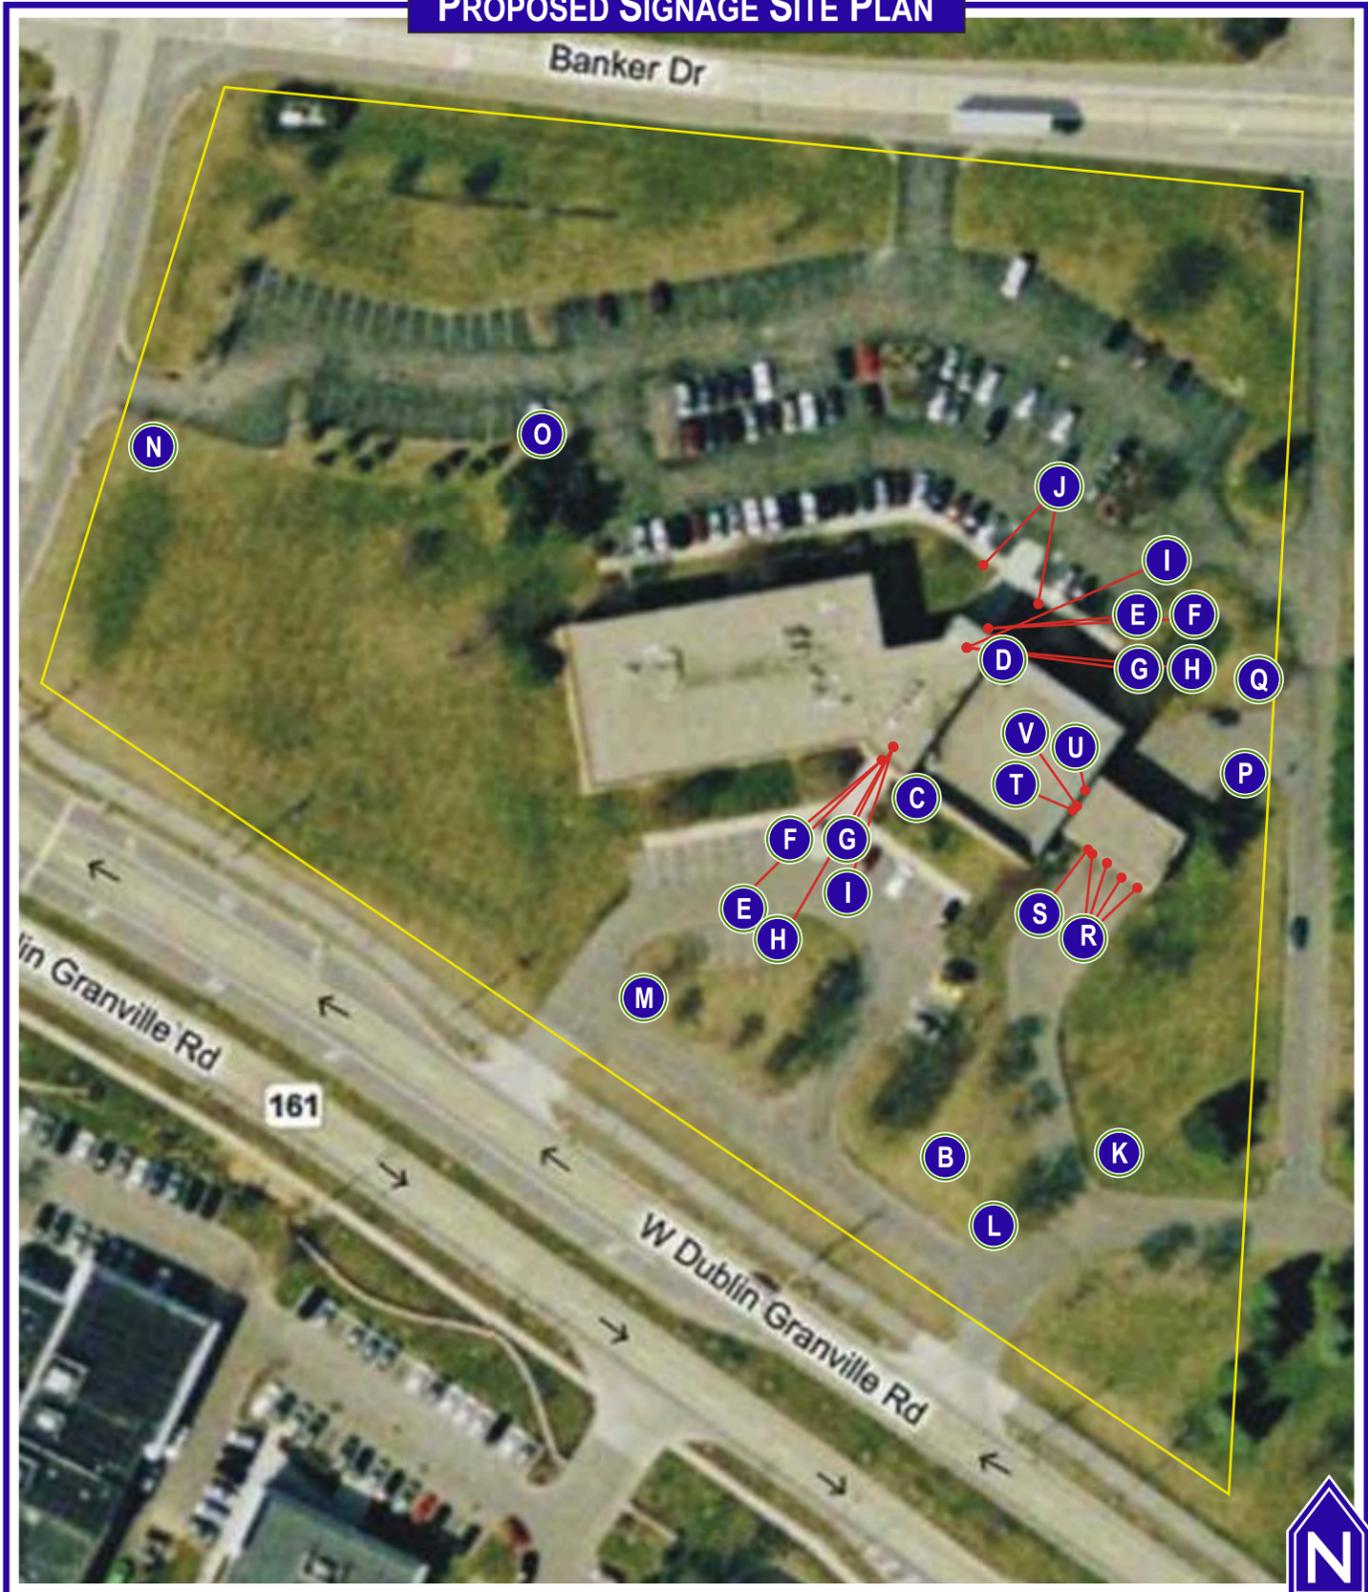

EXISTING & PROPOSED SIGNAGE SUMMARY					
SIGN	EXISTING SIGN TYPE	PROPOSED ACTION	PROPOSED SIGN TYPE	PRODUCT NUMBER	AREA (SF)
A	PYLON	REMOVE & REPLACE	PYLON	P24	24
B	PYLON	REMOVE & REPLACE	PYLON	P24	24
C	WALL SIGN	REMOVE & REPLACE	LETTERS-LOGO	WLV71RW	71
D	WALL SIGN	REMOVE & REPLACE	LETTERS-LOGO	WLV71RW	71
E(2)	VINYL	INSTALL NEW	HORIZON/SHIELD - VINYL	HS2-V	2 EA
F(2)	VINYL	REMOVE & REPLACE	ADDRESS VINYL	VRWL3-ADDR	3 EA
G(2)	VINYL	REMOVE, REPLACE & RELOCATE	VINYL HOURS	VS	2 EA
H(2)	VINYL	REMOVE, REPLACE & RELOCATE	VINYL HANDICAP	VH	1 EA
I(2)	VINYL	REMOVE, REPLACE & RELOCATE	EMERGENCY VINYL	BSOC	1 EA
J(2)	REGULATORY	REMOVE & REPLACE	REGULATORY - HANDICAP PARKING	RHP-OH250	2 EA
K	REGULATORY	REMOVE & REPLACE	DIRECTIONAL	D4	4
L	REGULATORY	REMOVE & REPLACE	DIRECTIONAL	D4	4
M	REGULATORY	REMOVE & REPLACE	DIRECTIONAL	D4	4
N	REGULATORY	REMOVE & REPLACE	REGULATORY - ENTER	R36-EN	2
O	REGULATORY	REMOVE ONLY			
P	REGULATORY	REMOVE & REPLACE	REGULATORY - DO NOT ENTER	R36-DNE	2
Q		INSTALL NEW	REGULATORY - DO NOT ENTER	R36-DNE	2
R(4)	REGULATORY	REMOVE & REPLACE	REGULATORY WALL PANEL - CLEARANCE	R1WP-CL	1 EA
S	REGULATORY	REMOVE & REPLACE	REGULATORY WALL PANEL - ATM	R1WP-ATM	1
T	VINYL	REMOVE & REPLACE	VINYL PANEL - DRIVE UP	VP-DU	2
U		INSTALL NEW	REGULATORY WALL PANEL - NIGHT DEP	R1WP-ND	1
V	ATM	REMAINS			
W	WALL SIGN	REMOVE, REPLACE & RELOCATE	HORIZON/SHIELD - NON ILLUM	HS35-NI	35



\*SIGN W IS LOCATED INSIDE BANKING CENTER AND IS NOT SHOWN ON SITE PLAN.



 9051 EXECUTIVE PARK DR. SUITE 200 KNOXVILLE, TN 37923 OFFICE: 865-539-4001 FAX: 865-539-0851 WWW.LINKENGR.COM	PROJECT SCOPE:	EXISTING FACILITY RE-BRAND - OH100486	
	LOCATION:	DUBLIN SAWMILL	AFFILIATE: FTCO
PAGE: 3 OF 28	DRAWING #: G239413R3	CITY, STATE, ZIP:	DUBLIN OH 43017
CURRENT REV: 3	ISSUE DATE: 09/06/11	PROJECT #:	11-0156
	APP: LK	DRAWN BY:	BL



REV	DATE	DESCRIPTION OF REVISION	BY	DATE	REVIEW - APPROVAL TYPE	STATUS	BY
4				09/06/11	CLIENT FINAL APPROVAL	<input checked="" type="checkbox"/> APPROVED	Fifth Third Bank - JJ
3	09/06/11	Approved per client	SG		LOCAL JURISDICTION PRELIMINARY REVIEW	<input type="checkbox"/> COMMENTS PROVIDED <input type="checkbox"/> REVISE & RESUBMIT <input type="checkbox"/> APPROVED AS NOTED <input checked="" type="checkbox"/> APPROVED	
2	08/22/11	Relocate Signs G-I. Relocate Sign W.	SG		OWNER/LL PRELIMINARY APPROVAL	<input type="checkbox"/> COMMENTS PROVIDED <input type="checkbox"/> REVISE & RESUBMIT <input type="checkbox"/> APPROVED AS NOTED <input checked="" type="checkbox"/> APPROVED	
1	05/16/11	Revise Signs A, B, C, D and Signs K - O per clients request.	BL	09/06/11	CLIENT PRELIMINARY APPROVAL	<input type="checkbox"/> COMMENTS PROVIDED <input type="checkbox"/> REVISE & RESUBMIT <input type="checkbox"/> APPROVED AS NOTED <input checked="" type="checkbox"/> APPROVED	Fifth Third Bank - JJ

**APPROVED**  
 LINK ENGINEERING, LLC  
 09-06-11

AFTER



BEFORE

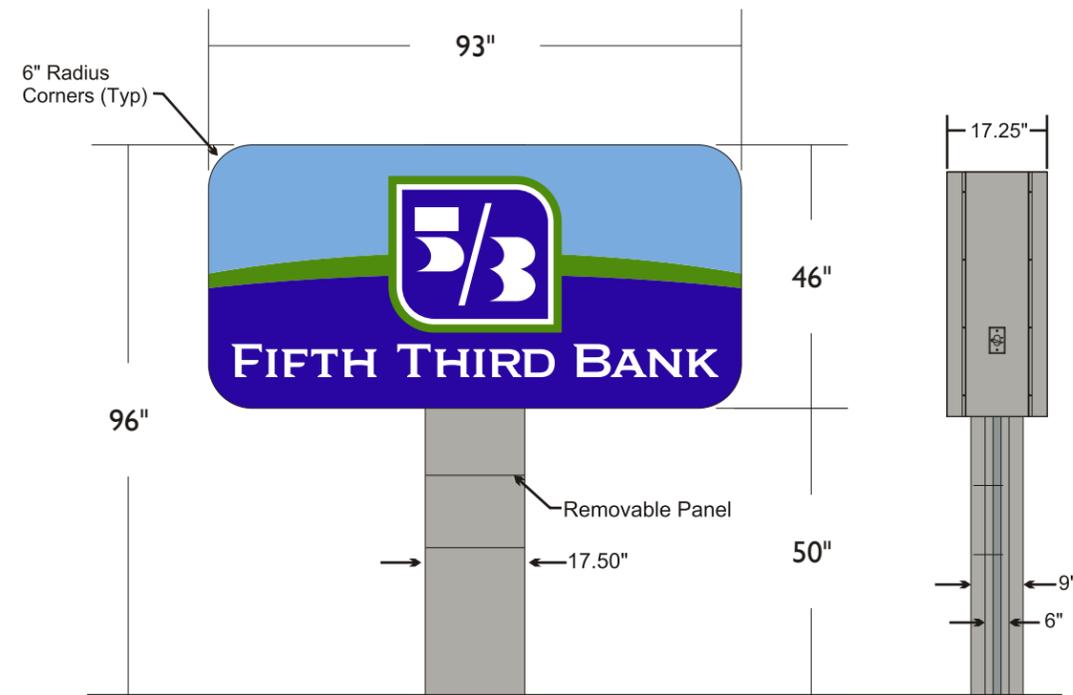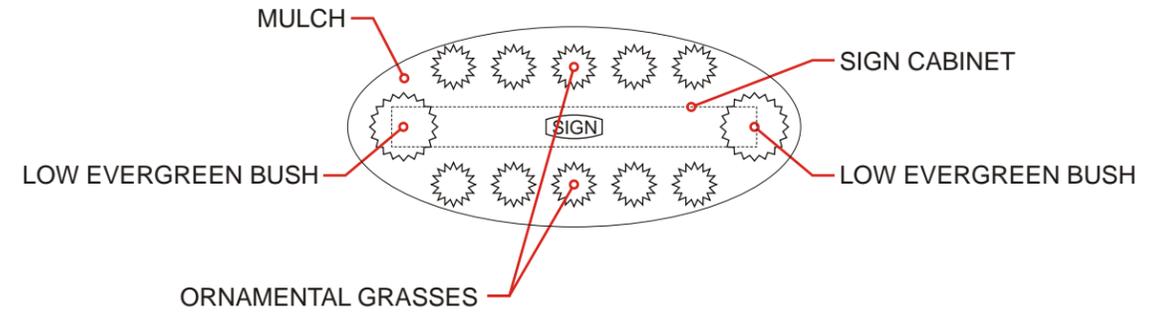

ELEVATION

SIDE VIEW

**CABINET**

- SignComp wide body extrusion (#2005), tension frame (#2085) with bleed tension frame cover (#2058) and 6" radius corner set (#4525).
- All to be painted Silver Grey MP55607.
- Inside (not frame braces) to be painted Lacryl Starbrite White.

**FACE:**

- Faces to be 3M 945 seamless White Panaflex. Background to be first surface applied 3M vinyls - Sky Blue 3632-8043 and Sapphire Blue 3632-8607.
- Horizon/Shield Logo graphics to be first surface applied 3M vinyls - Vivid Green 3632-156, Sapphire Blue 3632-8607 and white (weeded out of background vinyl).
- Logo Copy to be white (weeded out of background vinyl).

**MOUNTING:**

- One (1) internal steel support required.
- One (1) external steel support with match plate required.

**ELECTRICAL:**

- UL & NEC approval required.
- Lamp(s): (4) F84/T12/DL/HO.
- Ballast(s): (1) 4-lamp, 8'-32' electronic @ 1.7 amps.
- Total Load: 1.7 amps.
- Circuit(s): (1) 20 amp-120V
- Disconnect Switch: (1) 20 amp gang lever

**SIGN A**

**QTY - 1**

**FLOOR - N/A**

**ADDITIONAL FABRICATION & INSTALLATION NOTES**

**REMOVE EXISTING JEANIE CABINET**

**SIGN CAN ONLY HAVE 3 COLORS AND WHITE COUNTS AS A COLOR.**

**OVERALL BUILDING DIMENSIONS**

H = N/A

L = N/A

**EXISTING SIGN DIMENSIONS**

H = 60"

L = 72"

OAH = 156"

SQ FT = 30

**ADDITIONAL INFORMATION**



		9051 EXECUTIVE PARK DR., SUITE 200, KNOXVILLE, TN 37923 OFFICE: 865-539-4001 FAX: 865-539-0851 WWW.LINKENGR.COM		PROJECT SCOPE: <b>EXISTING FACILITY RE-BRAND - OH100486</b>		AFFILIATE: <b>FTCO</b>	
PAGE: 4 OF 28 CURRENT REV: 3		DRAWING #: <b>G239413R3</b> ISSUE DATE: <b>09/06/11</b>		LOCATION: <b>DUBLIN SAWMILL</b>		ADDRESS: <b>3800 WEST DUBLIN GRANVILLE ROAD</b>	
PROJECT #: <b>11-0156</b>		CITY, STATE, ZIP: <b>DUBLIN OH 43017</b>		DRAWN BY: <b>BL</b>		DRAWN BY: <b>BL</b>	

	3M VINYL	MAP PAINT		3M VINYL	MAP PAINT		3M VINYL	MAP PAINT
	Sapphire Blue (Translucent) 3632-8607	MP55619		White (Diffuser) 3635-70****			Silver Gray (Translucent) 3630-121	MP55607
	Sapphire Blue (Opaque) 180C-37	MP55619		White (Translucent) 3632-20	MP18336		Silver Gray (Opaque) 180C-120	MP55607
	Sapphire Blue*** 7725-37***			White (Opaque) 180C-10	MP18336		Red (Reflective) 680-72	
	Sky Blue (Translucent) 3632-8043*	MP55609		White (Reflective) 680-10	MP18336		Yellow (Reflective) 680-71	
	Vivid Green (Translucent) 3632-156*	MP55605**		White*** (Gerber Foil) GCS-10***			Black (Opaque) 180C-12	MP02281
	Apple Green*** (Gerber Foil) GSC-196***			Clear*** (Translucent) 7725-114***				

\* TO ACHIEVE OPAQUE FINISH FOR CUSTOM TRANSLUCENT VINYL COLORS - APPLY CUSTOM TRANSLUCENT VINYL OVER WHITE OPAQUE SUBSTRATE. 3M 180C-10 ONLY, WHITE PAINT, ETC.

\*\* TO BE APPLIED OVER 274908-274909 WHITE EPOXY PRIMER PER MATTHEWS PAINT COMPANY TO ACHIEVE APPROVED VIVID GREEN COLOR.

\*\*\* TO BE USED FOR FABRICATION OF BANK HOURS AND HANDICAP VINYL ONLY.

\*\*\*\* FOR SECOND SURFACE APPLICATION ONLY.

**APPROVED**  
LINK ENGINEERING, LLC  
09-06-11

AFTER



BEFORE



**SIGN B**

**QTY - 1**

**FLOOR - N/A**

**ADDITIONAL FABRICATION & INSTALLATION NOTES**

**REMOVE EXISTING JEANIE CABINET**

**SIGN CAN ONLY HAVE 3 COLORS AND WHITE COUNTS AS A COLOR.**

**OVERALL BUILDING DIMENSIONS**

H = N/A

L = N/A

**EXISTING SIGN DIMENSIONS**


H = 60"

L = 72"

OAH = 156"

SQ FT = 30

**ADDITIONAL INFORMATION**

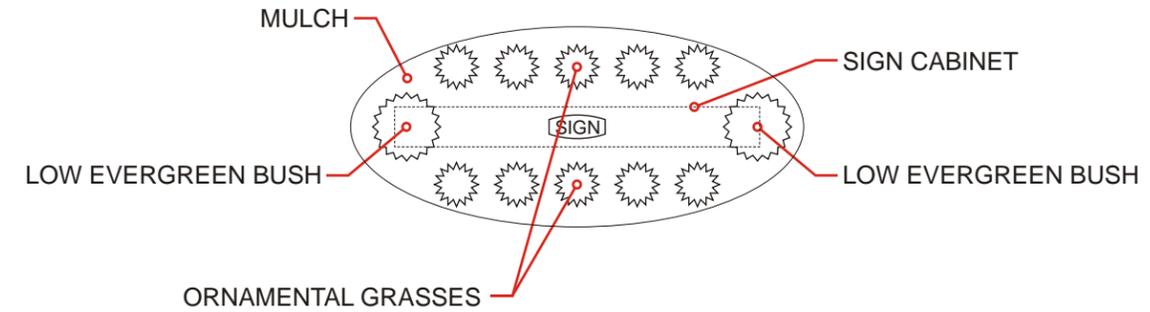

- CABINET**
- SignComp wide body extrusion (#2005), tension frame (#2085) with bleed tension frame cover (#2050) and 6" radius corner set (#4525).
  - All to be painted Silver Grey MP55607.
  - Inside (not frame braces) to be painted Lacryl Starbrite White.
- FACE:**
- Faces to be 3M 945 seamless White Panaflex. Background to be first surface applied 3M vinyls - Sky Blue 3632-8043 and Sapphire Blue 3632-8607.
  - Horizon/Shield Logo graphics to be first surface applied 3M vinyls - Vivid Green 3632-156, Sapphire Blue 3632-8607 and white (weeded out of background vinyl).
  - Logo Copy to be white (weeded out of background vinyl).
- MOUNTING:**
- One (1) internal steel support required.
  - One (1) external steel support with match plate required.
- ELECTRICAL:**
- UL & NEC approval required.
  - Lamp(s): (4) F84/T12/DL/HO.
  - Ballast(s): (1) 4-lamp, 8'-32' electronic @ 1.7 amps.
  - Total Load: 1.7 amps.
  - Circuit(s): (1) 20 amp-120V
  - Disconnect Switch: (1) 20 amp gang lever



		9051 EXECUTIVE PARK DR., SUITE 200, KNOXVILLE, TN 37923 OFFICE: 865-539-4001 FAX: 865-539-0851 WWW.LINKENGR.COM		PROJECT SCOPE: <b>EXISTING FACILITY RE-BRAND - OH100486</b>		AFFILIATE: <b>FTCO</b>	
LOCATION: <b>DUBLIN SAWMILL</b>		ADDRESS: <b>3800 WEST DUBLIN GRANVILLE ROAD</b>		CITY, STATE, ZIP: <b>DUBLIN OH 43017</b>		PROJECT #: <b>11-0156</b>	
PAGE: <b>5 OF 28</b> CURRENT REV: <b>3</b>		DRAWING #: <b>G239413R3</b> ISSUE DATE: <b>09/06/11</b>		APPR: <b>LK</b>		DRAWN BY: <b>BL</b>	

	3M VINYL	MAP PAINT		3M VINYL	MAP PAINT		3M VINYL	MAP PAINT
	Sapphire Blue (Translucent) 3632-8607	MP55619		White (Diffuser) 3635-70****			Silver Gray (Translucent) 3630-121	MP55607
	Sapphire Blue (Opaque) 180C-37	MP55619		White (Translucent) 3632-20	MP18336		Silver Gray (Opaque) 180C-120	MP55607
	Sapphire Blue*** 7725-37***			White (Opaque) 180C-10	MP18336		Red (Reflective) 680-72	
	Sky Blue (Translucent) 3632-8043*	MP55609		White (Reflective) 680-10	MP18336		Yellow (Reflective) 680-71	
	Vivid Green (Translucent) 3632-156*	MP55605**		White*** (Gerber Foil) GCS-10****			Black (Opaque) 180C-12	MP02281
	Apple Green*** (Gerber Foil) GSC-196***			Clear*** (Translucent) 7725-114****		ALL PAINT TO HAVE SATIN FINISH		

**APPROVED**  
LINK ENGINEERING, LLC  
09-06-11

\* TO ACHIEVE OPAQUE FINISH FOR CUSTOM TRANSLUCENT VINYL COLORS - APPLY CUSTOM TRANSLUCENT VINYL OVER WHITE OPAQUE SUBSTRATE. 3M 180C-10 ONLY, WHITE PAINT, ETC.  
 \*\* TO BE APPLIED OVER 274908-274909 WHITE EPOXY PRIMER PER MATTHEWS PAINT COMPANY TO ACHIEVE APPROVED VIVID GREEN COLOR.  
 \*\*\* TO BE USED FOR FABRICATION OF BANK HOURS AND HANDICAP VINYL ONLY.  
 \*\*\*\* FOR SECOND SURFACE APPLICATION ONLY.

AFTER



BEFORE



SIGN C

QTY - 1

FLOOR - N/A

ADDITIONAL FABRICATION & INSTALLATION NOTES

PATCH, PAINT, AND REPAIR FASCIA AS REQUIRED.

TRIM TREES AS REQUIRED FOR VISIBILITY. COORDINATE WITH VIOX PROJECT MANAGER.

OVERALL BUILDING DIMENSIONS

H = 26'-9"

L = 97'-0"

EXISTING SIGN DIMENSIONS

H = 38"


L = 264"

OAH = N/A


SQ FT = 70

ADDITIONAL INFORMATION

WLV71RW  
71SF WALL LETTERS - VERTICAL

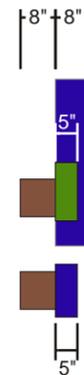

SIDE VIEW

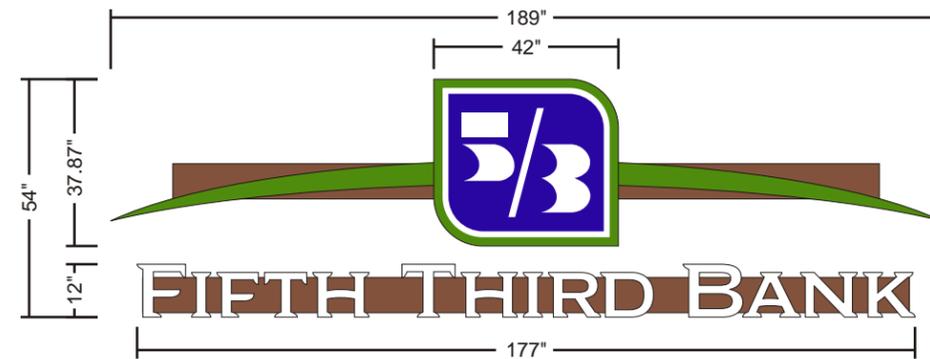

ELEVATION

CABINETS:

EDGE-LIT HORIZON LOGO:

- 5" deep custom shaped edge-lit cabinet.
- .063 cabinet side walls to be painted Vivid Green MP55605.
- Inside to be painted Lacryl Starbrite White.
- .080 aluminum back to be used.
- Faces to be .50" 2447 pigmented-white acrylic with first surface applied 3M vinyl- Vivid Green 3632-156.
- To be mounted flush to exterior wall as required.

EDGE-LIT LOGO COPY:

- 5" deep, edge-lit fabricated channel letters.
- .063 cabinet side walls to be painted Sapphire Blue MP55619.
- Inside to be painted Lacryl Starbrite White.
- .080 aluminum back to be used.
- Faces to be .50" 2447 pigmented-white acrylic with first surface applied 3M vinyl- White 3632-20.
- To be mounted flush to exterior wall as required.

CABINETS:

EDGE-LIT SHIELD LOGO:

- 8" deep custom shaped edge-lit cabinet with radius corners.
- .063 cabinet side walls to be painted Sapphire Blue MP55619.
- Inside to be painted Lacryl Starbrite White.
- .125 aluminum back to be used.
- Face to be .50" 2447 pigmented-white acrylic with first surface applied 3M vinyls-White 3632-20 (continuous) and Sapphire Blue 3632-8607 and Vivid Green 3632-156 (both applied over white).
- To be mounted flush to exterior wall as required.

ELECTRICAL:

- UL & NEC approval required.
- LED: (20) Reclume LED panels - white.
- Power Supply: (5) Advance LED - INTA-0012V-50-F-0 @ 0.061 amps each.
- Total Load: 3.05 amps.
- Circuit(s): (1) 20 amp-120V.
- Disconnect Switch: (1) 20 amp gang lever.

RACEWAY INSTALLATION



9051 EXECUTIVE PARK DR.  
SUITE 200  
KNOXVILLE, TN 37923  
OFFICE: 865-539-4001  
FAX: 865-539-0851  
WWW.LINKENGR.COM

PAGE: 6 OF 28  
DRAWING #: G239413R3  
CURRENT REV: 3  
ISSUE DATE: 09/06/11  
APPR: LK

PROJECT SCOPE: EXISTING FACILITY RE-BRAND - OH100486  
LOCATION: DUBLIN SAWMILL AFFILIATE: FTCCO  
ADDRESS: 3800 WEST DUBLIN GRANVILLE ROAD  
CITY, STATE, ZIP: DUBLIN OH 43017  
PROJECT #: 11-0156  
DRAWN BY: BL

	3M VINYL	MAP PAINT		3M VINYL	MAP PAINT		3M VINYL	MAP PAINT
Sapphire Blue (Translucent)	3632-8607	MP55619	White (Diffuser)	3635-70****		Silver Gray (Translucent)	3630-121	MP55607
Sapphire Blue (Opaque)	180C-37	MP55619	White (Translucent)	3632-20	MP18336	Silver Gray (Opaque)	180C-120	MP55607
Sapphire Blue***	7725-37***		White (Opaque)	180C-10	MP18336	Red (Reflective)	680-72	
Sky Blue (Translucent)	3632-8043*	MP55609	White (Reflective)	680-10	MP18336	Yellow (Reflective)	680-71	
Vivid Green (Translucent)	3632-156*	MP55605**	White*** (Gerber Foil)	GCS-10****		Black (Opaque)	180C-12	MP02281
Apple Green*** (Gerber Foil)	GSC-196***		Clear*** (Translucent)	7725-114****				

\* TO ACHIEVE OPAQUE FINISH FOR CUSTOM TRANSLUCENT VINYL COLORS - APPLY CUSTOM TRANSLUCENT VINYL OVER WHITE OPAQUE SUBSTRATE. 3M 180C-10 ONLY, WHITE PAINT, ETC.  
\*\* TO BE APPLIED OVER 274908-274909 WHITE EPOXY PRIMER PER MATTHEWS PAINT COMPANY TO ACHIEVE APPROVED VIVID GREEN COLOR.  
\*\*\* TO BE USED FOR FABRICATION OF BANK HOURS AND HANDICAP VINYL ONLY.  
\*\*\*\* FOR SECOND SURFACE APPLICATION ONLY.

APPROVED  
LINK ENGINEERING, LLC  
09-06-11

AFTER



BEFORE



SIGN D

QTY - 1

FLOOR - N/A

ADDITIONAL FABRICATION & INSTALLATION NOTES

PATCH, PAINT, AND REPAIR FASCIA AS REQUIRED.

TRIM TREES AS REQUIRED FOR VISIBILITY. COORDINATE WITH VIOX PROJECT MANAGER.

OVERALL BUILDING DIMENSIONS

H = 26'-9"

L = 97'-0"

EXISTING SIGN DIMENSIONS

H = 38"


L = 264"

OAH = N/A


SQ FT = 70

ADDITIONAL INFORMATION

WLV71RW  
71SF WALL LETTERS - VERTICAL

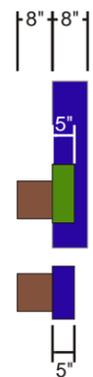

SIDE VIEW

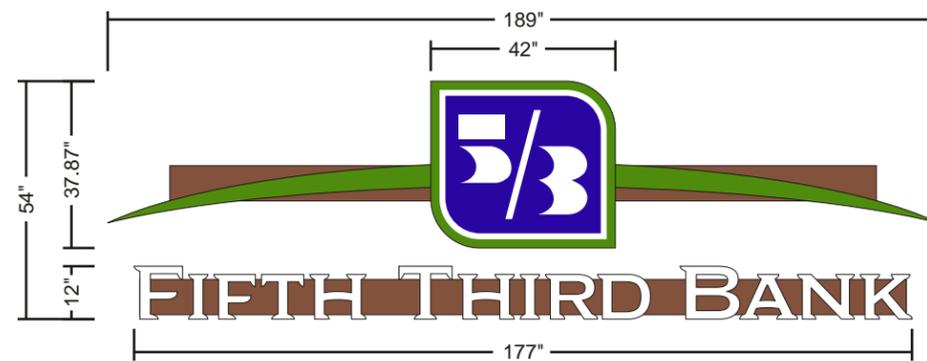

ELEVATION

CABINETS:

EDGE-LIT HORIZON LOGO:

- 5" deep custom shaped edge-lit cabinet.
- .063 cabinet side walls to be painted Vivid Green MP55605.
- Inside to be painted Lacryl Starbrite White.
- .080 aluminum back to be used.
- Faces to be .50" 2447 pigmented-white acrylic with first surface applied 3M vinyl- Vivid Green 3632-156.
- To be mounted flush to exterior wall as required.

EDGE-LIT LOGO COPY:

- 5" deep, edge-lit fabricated channel letters.
- .063 cabinet side walls to be painted Sapphire Blue MP55619.
- Inside to be painted Lacryl Starbrite White.
- .080 aluminum back to be used.
- Faces to be .50" 2447 pigmented-white acrylic with first surface applied 3M vinyl- White 3632-20.
- To be mounted flush to exterior wall as required.

CABINETS:

EDGE-LIT SHIELD LOGO:

- 8" deep custom shaped edge-lit cabinet with radius corners.
- .063 cabinet side walls to be painted Sapphire Blue MP55619.
- Inside to be painted Lacryl Starbrite White.
- .125 aluminum back to be used.
- Face to be .50" 2447 pigmented-white acrylic with first surface applied 3M vinyls-White 3632-20 (continuous) and Sapphire Blue 3632-8607 and Vivid Green 3632-156 (both applied over white).
- To be mounted flush to exterior wall as required.

ELECTRICAL:

- UL & NEC approval required.
- LED: (20) Reklume LED panels - white.
- Power Supply: (5) Advance LED - INTA-0012V-50-F-0 @ 0.061 amps each.
- Total Load: 3.05 amps.
- Circuit(s): (1) 20 amp-120V.
- Disconnect Switch: (1) 20 amp gang lever.

RACEWAY INSTALLATION



		9051 EXECUTIVE PARK DR. SUITE 200 KNOXVILLE, TN 37923 OFFICE: 865-539-4001 FAX: 865-539-0851 WWW.LINKENGR.COM		PROJECT SCOPE: <b>EXISTING FACILITY RE-BRAND - OH100486</b>		AFFILIATE: <b>FTCO</b>	
LOCATION: <b>DUBLIN SAWMILL</b>		ADDRESS: <b>3800 WEST DUBLIN GRANVILLE ROAD</b>		CITY, STATE, ZIP: <b>DUBLIN OH 43017</b>		PROJECT #: <b>11-0156</b>	
DRAWING #: <b>G239413R3</b>		ISSUE DATE: <b>09/06/11</b>		APPR: <b>LK</b>		DRAWN BY: <b>BL</b>	
PAGE: <b>6 OF 28</b>		CURRENT REV: <b>3</b>		PROJECT #: <b>11-0156</b>		DRAWN BY: <b>BL</b>	

	3M VINYL	MAP PAINT		3M VINYL	MAP PAINT		3M VINYL	MAP PAINT
	Sapphire Blue (Translucent) 3632-8607	MP55619		White (Diffuser) 3635-70****			Silver Gray (Translucent) 3630-121	MP55607
	Sapphire Blue (Opaque) 180C-37	MP55619		White (Translucent) 3632-20	MP18336		Silver Gray (Opaque) 180C-120	MP55607
	Sapphire Blue*** (Opaque) 7725-37***			White (Opaque) 180C-10	MP18336		Red (Reflective) 680-72	
	Sky Blue (Translucent) 3632-8043*	MP55609		White (Reflective) 680-10	MP18336		Yellow (Reflective) 680-71	
	Vivid Green (Translucent) 3632-156*	MP55605**		White*** (Gerber Foil) GCS-10***			Black (Opaque) 180C-12	MP02281
	Apple Green*** (Gerber Foil) GSC-196***			Clear*** (Translucent) 7725-114***		<b>ALL PAINT TO HAVE SATIN FINISH</b>		

\* TO ACHIEVE OPAQUE FINISH FOR CUSTOM TRANSLUCENT VINYL COLORS - APPLY CUSTOM TRANSLUCENT VINYL OVER WHITE OPAQUE SUBSTRATE. 3M 180C-10 INK, WHITE PAINT, ETC.

\*\* TO BE APPLIED OVER 274908-274909 WHITE EPOXY PRIMER PER MATTHEWS PAINT COMPANY TO ACHIEVE APPROVED VIVID GREEN COLOR.

\*\*\* TO BE USED FOR FABRICATION OF BANK HOURS AND HANDICAP VINYL ONLY.

\*\*\*\* FOR SECOND SURFACE APPLICATION ONLY.

**APPROVED**  
LINK ENGINEERING, LLC  
09-06-11

AFTER



BEFORE



2 SQ FT HORIZON/SHIELD-VINYL

SIGN E


HS2-V

QTY - 2

FLOOR - N/A

ADDITIONAL FABRICATION & INSTALLATION NOTES

LOCATED ABOVE EACH ENTRANCE.

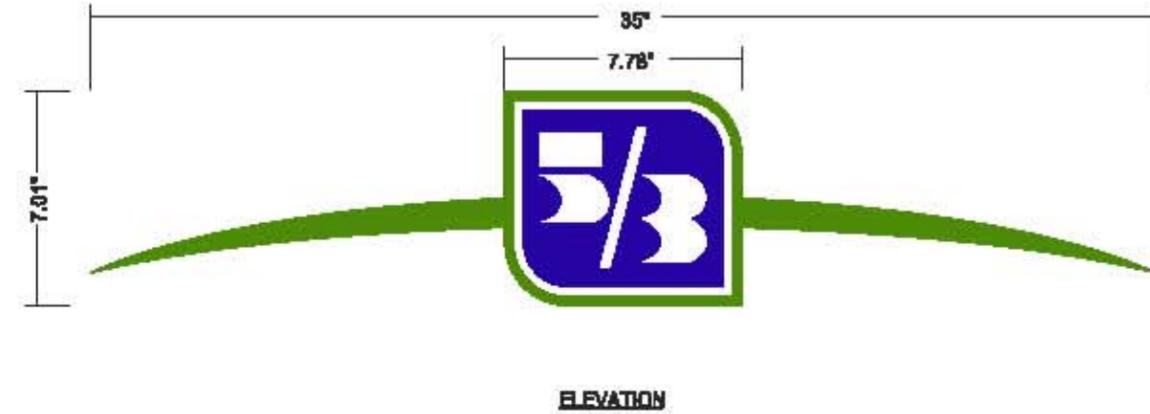

VINYL:

- Horizon/Shield Logo as shown consists of first surface applied 3M vinyl -Vivid Green 3632-158 (over White 3632-20), Sapphire Blue 180C-37 and White 3632-20.

OVERALL BUILDING DIMENSIONS

H = 25'-0"

L = 97'-0"

EXISTING SIGN DIMENSIONS

H = N/A

L = N/A

OAH = N/A

SQ FT = N/A

ADDITIONAL INFORMATION



		PROJECT SCOPE: <b>EXISTING FACILITY RE-BRAND - OH100488</b>	
9031 EXECUTIVE PARK DR. SUITE 300 CINCINNATI, OH 45240 PHONE: 513-952-4400 WWW.LINKHERRING.COM		LOCATION: <b>DUBLIN SAWNELL</b>	AGENCY: <b>FTCO</b>
PAGE: <b>8 OF 28</b> CURRENT REV: <b>3</b>		ADDRESS: <b>3899 WEST DUBLIN @ GRANVILLE ROAD</b>	
DRAWING #: <b>Q238413R3</b> DATE: <b>09/08/11</b>		CITY, STATE, ZIP: <b>DUBLIN OH 43017</b>	
PROJECT #: <b>11-0188</b>		DRAWING BY: <b>BL</b>	

3M VINYL		MAP PAINT		3M VINYL		MAP PAINT		3M VINYL		MAP PAINT	
Sapphire Blue (Standard)	3032-8007	MP05519	White (Standard)	3030-70	Silver Gray (Standard)	3030-121	MP05507	Silver Gray (Standard)	180C-120	MP05507	
Sapphire Blue (Special)	180C-37	MP05510	White (Special)	180C-10	MP15336	Red (Standard)	600-72	Red (Standard)	600-72	MP15336	
Sapphire Blue*** (Special)	7755-87		White (Special)	800-10	MP15336	Yellow (Standard)	600-71	Yellow (Standard)	600-71	MP15336	
Sky Blue (Standard)	3032-8043*	MP05508	White (Special)	OCG-10		Black (Standard)	180C-12	Black (Standard)	180C-12	MP02201	
Vivid Green (Standard)	3632-158*	MP05502**	Clear*** (Standard)	7735-154							
Apple Green*** (Standard)	USC-180										

\* TO ACHIEVE OPACQUE FINISH FOR CUSTOM TRANSLUCENT VINYL COLORS - APPLY CUSTOM TRANSLUCENT VINYL OVER WHITE OPACQUE SUBSTRATE, 3M 1800-18 W/White Primer STD. \*\* TO BE APPLIED OVER 27486-27488 WHITE EPOXY PRIMER FOR MATTHEWS PAINT COMPANY TO ACHIEVE APPROVED VIVID GREEN COLOR. \*\*\* TO BE USED FOR FABRICATION OF BANK LOGOS AND HANGERS VINYL ONLY. \*\*\*\* FOR SECOND SURFACE APPLICATION ONLY.

APPROVED  
LINK E. HERRING & CO., LLC  
09-08-11


AFTER



BEFORE



3 SQ FT REGULATORY WALL LETTERS - ADDRESS - VINYL

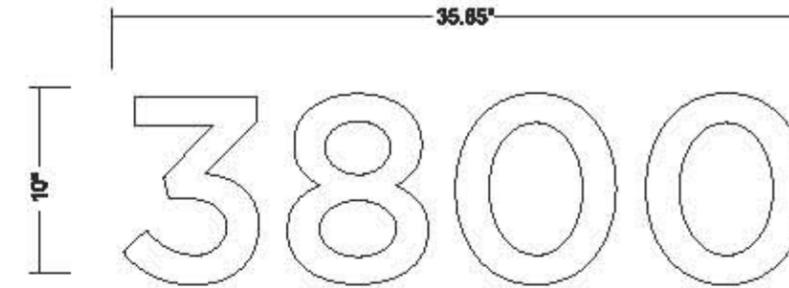

ELEVATION

VINYL:

- Text to be first surface applied 3M vinyl - White 180C-10.
- Type style to be Gotham-Medium.

**SIGN F**  
**VRWL3-ADDR**  
**QTY - 2**  
**FLOOR - N/A**

ADDITIONAL FABRICATION & INSTALLATION NOTES

OVERALL BUILDING DIMENSIONS

H = 25'-0"

L = 97'-0"

EXISTING SIGN DIMENSIONS

H = 5.5'

L = 24"

OAH = N/A

SQ FT = 2

ADDITIONAL INFORMATION



		PROJECT SCOPE: EXISTING FACILITY RE-BRAND - OH100488 WORKER: DUBLIN SAWMILL ADDRESS: 3800 WEST DUBLIN GRANVILLE ROAD CITY, STATE, ZIP: DUBLIN OH 43017 PHONE: 614-233-4138 FAX: 614-233-4138 WWW: WWW.LINKHERRING.COM		APPROVE: FTCO DRAWN BY: LK DATE: 09/08/11
PAGE: 9 OF 28 CURRENT REV: 3	SHEET #: DATE: 09/08/11	PROJECT #: 11-0188	ROOM #: BL	

3M VINYL		MAP PAINT		3M VINYL		MAP PAINT		3M VINYL		MAP PAINT	
Sapphire Blue (Standard)	3032-8007	MP06519	White (Standard)	3030-70***	Silver Gray (Standard)	3030-121	MP06607	Silver Gray (Standard)	180C-120	MP06607	
Sapphire Blue*** (Standard)	180C-37	MP06510	White (Standard)	180C-30	MP18336	Red (Standard)	080-72	MP18336	080-72	MP18336	
Sapphire Blue*** (Standard)	7755-87***		White (Standard)	180C-10	MP18336	Yellow (Standard)	080-71	MP18336	080-71	MP18336	
Sky Blue (Standard)	3032-8043*	MP06508	White (Standard)	88C-10	MP18336	Black (Standard)	180C-12	MP02201	180C-12	MP02201	
Vivid Green (Standard)	3032-105*	MP06502**	White*** (Standard)	OCG-10***							
Apple Green*** (Standard)	USC-180***		Clear*** (Standard)	7735-154***							

\* TO ACHIEVE OPAQUE FINISH FOR CUSTOM TRANSLUCENT VINYL COLORS - APPLY CUSTOM TRANSLUCENT VINYL OVER WHITE OPAQUE SUBSTRATE, 3M 180C-10, White Paint, STD.  
 \*\* TO BE APPLIED OVER 27486-27488 WHITE EPOXY PRIMER FOR MATTHEWS PAINT COMPANY TO ACHIEVE APPROVED VIVID GREEN COLOR.  
 \*\*\* TO BE USED FOR FABRICATION OF BANK LOGOS AND HARDWARE VINYL ONLY.  
 \*\*\*\* FOR SECOND SURFACE APPLICATION ONLY.



AFTER




BEFORE




**EXISTING EXTERIOR VINYL TO BE REMOVED. ALL NEW VINYL TO BE LOCATED ON INTERIOR FINANCIAL CENTER ENTRANCE DOORS.**

**2 SQ FT VINYL BANKING HOURS PANEL**

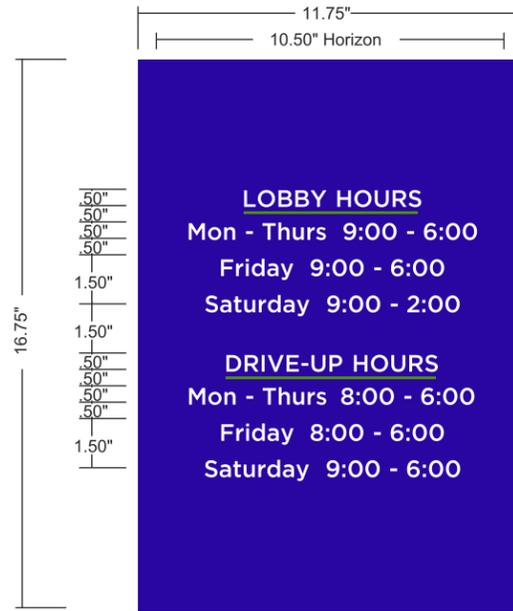

FRONT

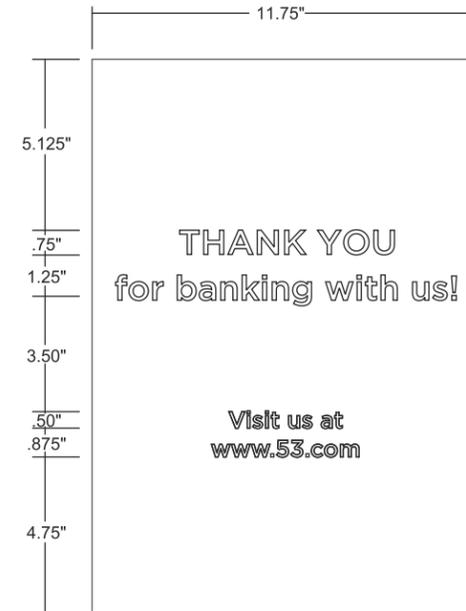

(LOOKING AT) BACK

**NOTE**  
Banking hours shown for example only. Verify actual banking hours prior to manufacturing.

**FRONT:**

- Background Panel to be 3M vinyl- Opaque Sapphire Blue 7725-37.
- Horizon/Shield Logo and Logo Copy to be Gerber Apple Green Foil GCS-196 and Gerber White Foil GCS-10.
- Text to be Gerber White Foil GCS-10.
- Rules to be Gerber Apple Green Foil GCS-196.
- Type style to be Gotham-Medium.


**BACK:**

- Background Panel to be 3M vinyl- Translucent Clear 7725-114.
- Background Panel text graphics to be reverse cut to be read correctly through clear vinyl and adhesive.
- Text to be Gerber White Foil GCS-10.
- Type style to be Gotham-Medium.

**INSTALLATION:**

- Combined Front and Back Panels to be first surface applied as shown.

**VINYL PLACEMENT DETAIL**

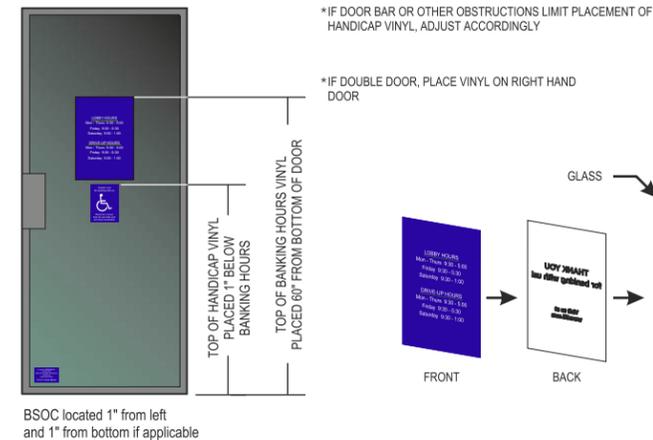

**SIGN G**  
**VS**  
**QTY - 2**  
**FLOOR - N/A**

**ADDITIONAL FABRICATION & INSTALLATION NOTES**

**SEE ILLUSTRATION FOR SIGN PLACEMENT**

**OVERALL BUILDING DIMENSIONS**

H = 26'-9"

L = 97'-0"

**EXISTING SIGN DIMENSIONS**

H = 16.75"

L = 11.75"

OAH = N/A

SQ FT = 2

**ADDITIONAL INFORMATION**



		9051 EXECUTIVE PARK DR., SUITE 200, KNOXVILLE, TN 37923 OFFICE: 865-539-4001 FAX: 865-539-0851 WWW.LINKENGR.COM		PROJECT SCOPE: <b>EXISTING FACILITY RE-BRAND - OH100486</b>		AFFILIATE: <b>FTCO</b>	
LOCATION: <b>DUBLIN SAWMILL</b>		ADDRESS: <b>3800 WEST DUBLIN GRANVILLE ROAD</b>		CITY, STATE, ZIP: <b>DUBLIN OH 43017</b>		PROJECT #: <b>11-0156</b>	
DRAWING #: <b>G239413R3</b>		ISSUE DATE: <b>09/06/11</b>		APPR: <b>LK</b>		DRAWN BY: <b>BL</b>	
PAGE: <b>10 OF 28</b>		CURRENT REV: <b>3</b>		PROJECT #: <b>11-0156</b>		DRAWN BY: <b>BL</b>	

	3M VINYL	MAP PAINT		3M VINYL	MAP PAINT		3M VINYL	MAP PAINT
	Sapphire Blue (Translucent) 3632-8607	MP55619		White (Diffuser) 3635-70****			Silver Gray (Translucent) 3630-121	MP55607
	Sapphire Blue (Opaque) 180C-37	MP55619		White (Translucent) 3632-20	MP18336		Silver Gray (Opaque) 180C-120	MP55607
	Sapphire Blue*** 7725-37***			White (Opaque) 180C-10	MP18336		Red (Reflective) 680-72	
	Sky Blue (Translucent) 3632-8043*	MP55609		White (Reflective) 680-10	MP18336		Yellow (Reflective) 680-71	
	Vivid Green (Translucent) 3632-156*	MP55605**		White*** (Gerber Foil) GCS-10***			Black (Opaque) 180C-12	MP02281
	Apple Green*** (Gerber Foil) GSC-196***			Clear*** (Translucent) 7725-114***				


\* TO ACHIEVE OPAQUE FINISH FOR CUSTOM TRANSLUCENT VINYL COLORS - APPLY CUSTOM TRANSLUCENT VINYL OVER WHITE OPAQUE SUBSTRATE. 3M 180C-10 INK, WHITE PAINT, ETC.  
 \*\* TO BE APPLIED OVER 274908-274909 WHITE EPOXY PRIMER PER MATTHEWS PAINT COMPANY TO ACHIEVE APPROVED VIVID GREEN COLOR.  
 \*\*\* TO BE USED FOR FABRICATION OF BANK HOURS AND HANDICAP VINYL ONLY.  
 \*\*\*\* FOR SECOND SURFACE APPLICATION ONLY.

**APPROVED**  
LINK ENGINEERING, LLC  
09-06-11

AFTER



BEFORE

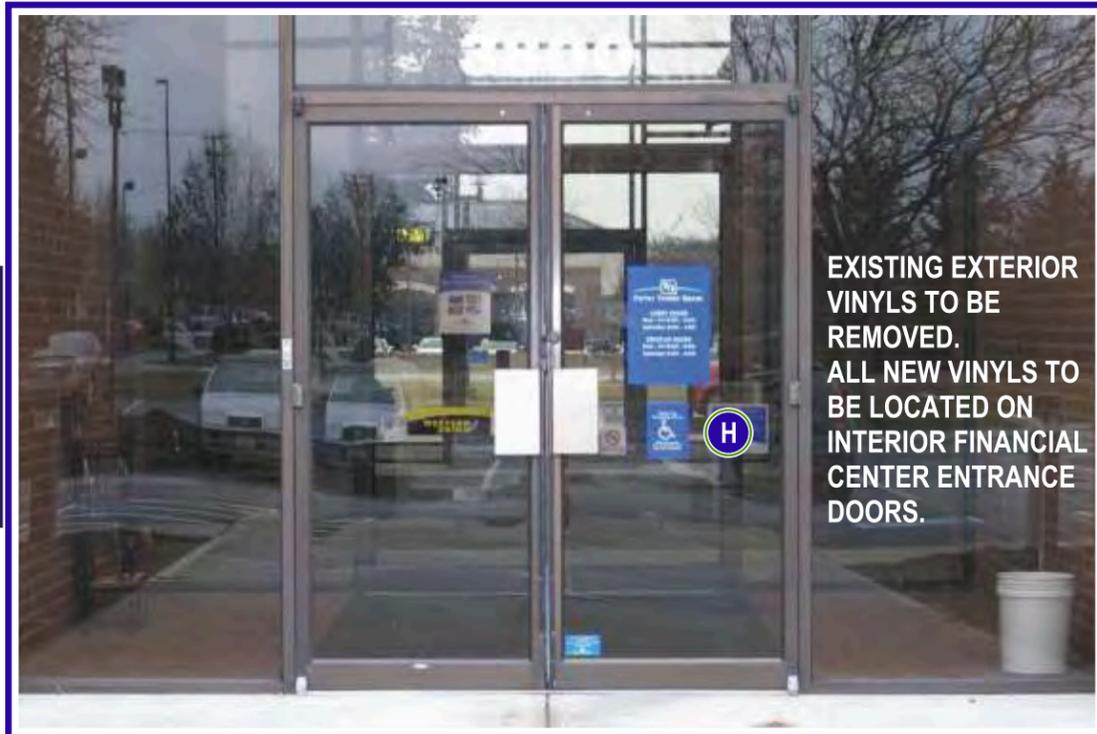

1 SQ FT VINYL HANDICAP PANEL

SIGN H

VH

QTY - 2

FLOOR - N/A

ADDITIONAL FABRICATION & INSTALLATION NOTES

SEE ILLUSTRATION FOR SIGN PLACEMENT

OVERALL BUILDING DIMENSIONS

H = 26'-9"

L = 97'-0"

EXISTING SIGN DIMENSIONS

H = 7.75"

L = 5.875"

OAH = N/A


SQ FT = 1

ADDITIONAL INFORMATION



\*Capital Letter Height

FRONT

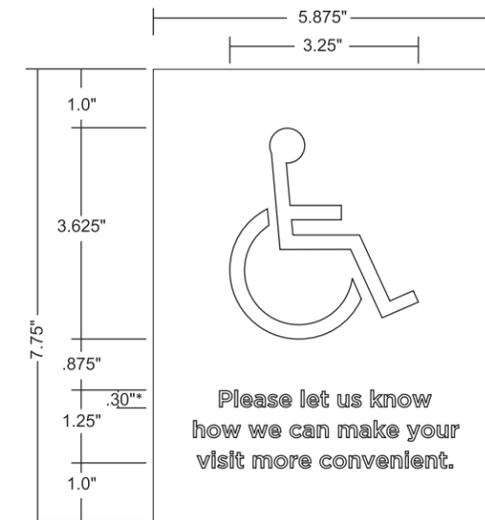

\*Capital Letter Height

(LOOKING AT) BACK

FRONT:

- Background Panel to be 3M vinyl- Opaque Sapphire Blue 7725-37.
- Graphics and Text to be Gerber White Foil GCS-10.
- Type style to be Gotham-Medium.


BACK:

- Background Panel to be 3M vinyl- Translucent Clear 7725-114.
- Background Panel text graphics to be reverse cut to be read correctly through clear vinyl and adhesive.
- Text to be Gerber White Foil GCS-10.
- Type style to be Gotham-Medium.

INSTALLATION:

- Combined Front and Back Panels to be first surface applied as shown.

VINYL PLACEMENT DETAIL

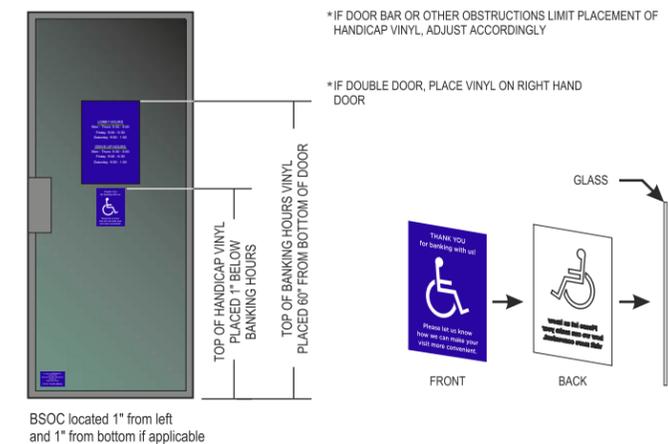

BSOC located 1" from left and 1" from bottom if applicable

\*IF DOOR BAR OR OTHER OBSTRUCTIONS LIMIT PLACEMENT OF HANDICAP VINYL, ADJUST ACCORDINGLY

\*IF DOUBLE DOOR, PLACE VINYL ON RIGHT HAND DOOR



		9051 EXECUTIVE PARK DR., SUITE 200, KNOXVILLE, TN 37923 OFFICE: 865-539-4001 FAX: 865-539-0851 WWW.LINKENGR.COM		PROJECT SCOPE: <b>EXISTING FACILITY RE-BRAND - OH100486</b>		AFFILIATE: <b>FTCO</b>	
LOCATION: <b>DUBLIN SAWMILL</b>		ADDRESS: <b>3800 WEST DUBLIN GRANVILLE ROAD</b>		CITY, STATE, ZIP: <b>DUBLIN OH 43017</b>		PROJECT #: <b>11-0156</b>	
DRAWING #: <b>G239413R3</b>		ISSUE DATE: <b>09/06/11</b>		APPR: <b>LK</b>		DRAWN BY: <b>BL</b>	
PAGE: <b>11 OF 28</b>		CURRENT REV: <b>3</b>		PROJECT #: <b>11-0156</b>		DRAWN BY: <b>BL</b>	

	3M VINYL	MAP PAINT		3M VINYL	MAP PAINT		3M VINYL	MAP PAINT
	Sapphire Blue (Translucent) 3632-8607	MP55619		White (Diffuser) 3635-70****			Silver Gray (Translucent) 3630-121	MP55607
	Sapphire Blue (Opaque) 180C-37	MP55619		White (Translucent) 3632-20	MP18336		Silver Gray (Opaque) 180C-120	MP55607
	Sapphire Blue*** (Opaque) 7725-37***			White (Opaque) 180C-10	MP18336		Red (Reflective) 680-72	
	Sky Blue (Translucent) 3632-8043*	MP55609		White (Reflective) 680-10	MP18336		Yellow (Reflective) 680-71	
	Vivid Green (Translucent) 3632-156*	MP55605**		White*** (Gerber Foil) GCS-10***			Black (Opaque) 180C-12	MP02281
	Apple Green*** (Gerber Foil) GSC-196***			Clear*** (Translucent) 7725-114***				

\* TO ACHIEVE OPAQUE FINISH FOR CUSTOM TRANSLUCENT VINYL COLORS - APPLY CUSTOM TRANSLUCENT VINYL OVER WHITE OPAQUE SUBSTRATE. 3M 180C-10 INK, WHITE PAINT, ETC.

\*\* TO BE APPLIED OVER 274908-274909 WHITE EPOXY PRIMER PER MATTHEWS PAINT COMPANY TO ACHIEVE APPROVED VIVID GREEN COLOR.

\*\*\* TO BE USED FOR FABRICATION OF BANK HOURS AND HANDICAP VINYL ONLY.

\*\*\*\* FOR SECOND SURFACE APPLICATION ONLY.

**APPROVED**  
LINK ENGINEERING, LLC  
09-06-11

AFTER



BEFORE



EXISTING EXTERIOR VINYL TO BE REMOVED. ALL NEW VINYL TO BE LOCATED ON INTERIOR FINANCIAL CENTER ENTRANCE DOORS.

1 SQ FT VINYL EMERGENCY PANEL




FRONT

REPLACEMENT/ RELOCATION OF FDIC AND SECURITY VINYL COORDINATED BY VIOX PROJECT MANAGER VIA BANK

- FRONT:
- Decal furnished by Fifth Third Bank.

VINYL PLACEMENT DETAIL

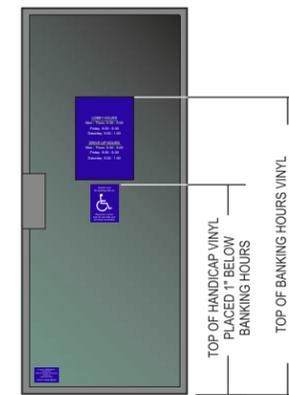

BSOC located 1" from left and 1" from bottom if applicable

SIGN I  
BSOC  
QTY - 2  
FLOOR - N/A

ADDITIONAL FABRICATION & INSTALLATION NOTES

SEE ILLUSTRATION FOR SIGN PLACEMENT

OVERALL BUILDING DIMENSIONS

H = 26'-9"

L = 97'-0"

EXISTING SIGN DIMENSIONS

H = 3"

L = 5"

OAH = N/A

SQ FT = 1

ADDITIONAL INFORMATION



		9051 EXECUTIVE PARK DR. SUITE 200 KNOXVILLE, TN 37923 OFFICE: 865-539-4001 FAX: 865-539-0851 WWW.LINKENGR.COM		PROJECT SCOPE: <b>EXISTING FACILITY RE-BRAND - OH100486</b>		AFFILIATE: <b>FTCO</b>	
PAGE: 12 OF 28 CURRENT REV: 3		DRAWING #: <b>G239413R3</b> ISSUE DATE: 09/06/11 APPR: LK		LOCATION: <b>DUBLIN SAWMILL</b>		ADDRESS: <b>3800 WEST DUBLIN GRANVILLE ROAD</b>	
CITY, STATE, ZIP: <b>DUBLIN OH 43017</b>		PROJECT #: <b>11-0156</b>		DRAWN BY: <b>BL</b>			

	3M VINYL	MAP PAINT		3M VINYL	MAP PAINT		3M VINYL	MAP PAINT
	Sapphire Blue (Translucent) 3632-8607	MP55619		White (Diffuser) 3635-70****			Silver Gray (Translucent) 3630-121	MP55607
	Sapphire Blue (Opaque) 180C-37	MP55619		White (Translucent) 3632-20	MP18336		Silver Gray (Opaque) 180C-120	MP55607
	Sapphire Blue*** (Opaque) 7725-37***			White (Opaque) 180C-10	MP18336		Red (Reflective) 680-72	
	Sky Blue (Translucent) 3632-8043*	MP55609		White (Reflective) 680-10	MP18336		Yellow (Reflective) 680-71	
	Vivid Green (Translucent) 3632-156*	MP55605**		White*** (Gerber Foil) GCS-10****			Black (Opaque) 180C-12	MP02281
	Apple Green*** (Gerber Foil) GSC-196***			Clear*** (Translucent) 7725-114****		ALL PAINT TO HAVE SATIN FINISH **** FOR SECOND SURFACE APPLICATION ONLY.		

\* TO ACHIEVE OPAQUE FINISH FOR CUSTOM TRANSLUCENT VINYL COLORS - APPLY CUSTOM TRANSLUCENT VINYL OVER WHITE OPAQUE SUBSTRATE. 3M 180C-10 INK, WHITE PAINT, ETC.  
 \*\* TO BE APPLIED OVER 274908-274909 WHITE EPOXY PRIMER PER MATTHEWS PAINT COMPANY TO ACHIEVE APPROVED VIVID GREEN COLOR.  
 \*\*\* TO BE USED FOR FABRICATION OF BANK HOURS AND HANDICAP VINYL ONLY.  
 \*\*\*\* FOR SECOND SURFACE APPLICATION ONLY.

APPROVED  
LINK ENGINEERING, LLC  
09-06-11

AFTER




BEFORE



2 SQ FT REGULATORY @ 7'0" OAH

**SIGN J**  
RHP-OH250  
QTY - 2  
FLOOR - N/A

ADDITIONAL FABRICATION & INSTALLATION NOTES

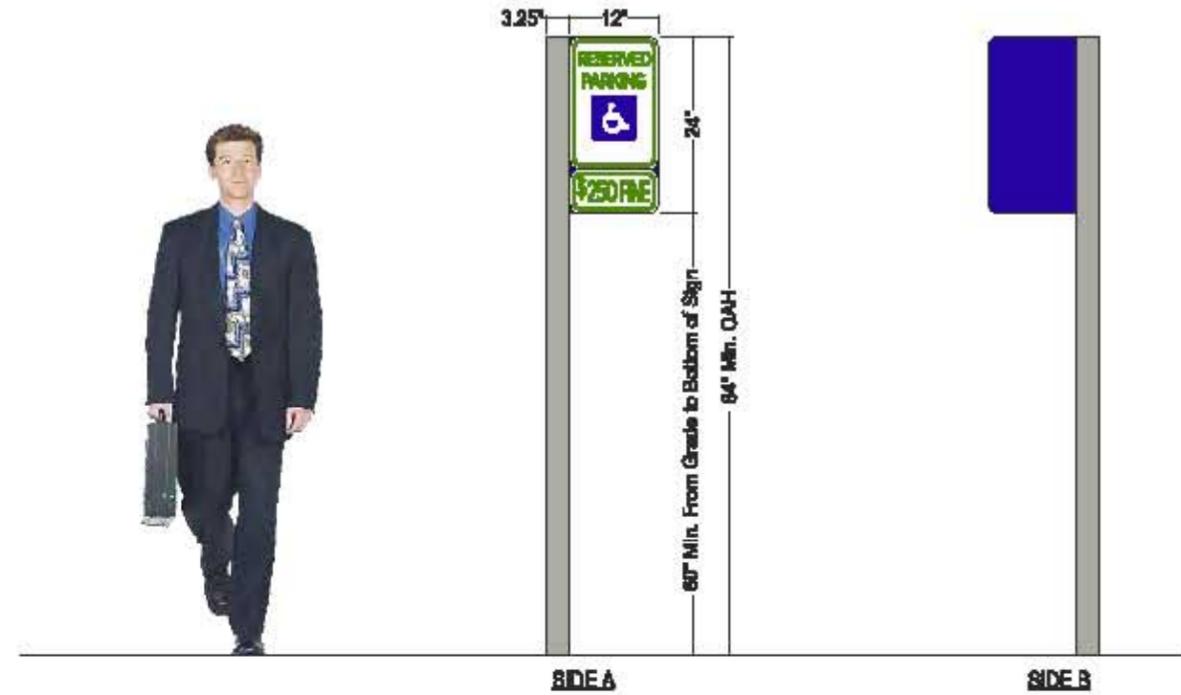

**SIGN PANEL:**

- .190" aluminum panel with radius corners (outside edge only).
- All to be painted Sapphire Blue MP5581B.

**SIGN POST:**


- SignComp Architectural Sign Post (#1005) with SignComp Post Cap (#6262).
- To be painted Silver Gray MP55807.

**COPY:**

- Graphics & Text to be first surface applied 3M vinyl per Ohio DOT Standards & Requirements.

**INSTALLATION:**

- Extruded aluminum post to be direct buried.

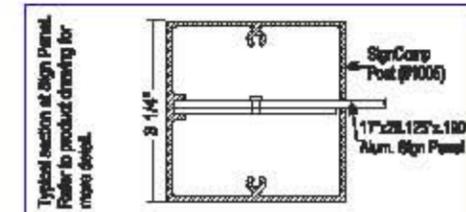

**OVERALL BUILDING DIMENSIONS**

H = N/A

L = N/A

**EXISTING SIGN DIMENSIONS**

H = 24"

L = 24"

OAH = 60.25"

SQ FT = 4

**ADDITIONAL INFORMATION**



		PROJECT SCOPE: EXISTING FACILITY RE-BRAND - OH100488 WORKER: DUBLIN SAMPBELL ADDRESS: 3899 WEST DUBLIN @ GRANVILLE ROAD CITY, STATE, ZIP: DUBLIN OH 43017 PHONE: 614-233-4138 FAX: 614-233-4138 WWW: WWW.FIFTHTHIRDBANK.COM		APPROVE: FTCO
PAGE: 13 OF 28 CURRENT REV: 3	SHEET #: Q238413R3 DATE: 09/08/11 BY: LK	PROJECT #: 11-0188 DRAWN BY: BL		

3M VINYL		MAP PAINT		3M VINYL		MAP PAINT		3M VINYL		MAP PAINT	
Sapphire Blue (Standard)	3032-9007	MP05519	White (Standard)	3030-70	Silver Gray (Standard)	3030-121	MP05507	Silver Gray (Standard)	180C-120	MP05507	
Sapphire Blue (Special)	180C-37	MP05510	White (Special)	3032-30	MP18336	Red (Standard)	600-72	Yellow (Standard)	600-71	Black (Standard)	180C-12
Sapphire Blue*** (Special)	7725-87		White (Special)	180C-10	MP18336	Yellow (Special)	600-71	Black (Special)	180C-12	MP02201	
Sky Blue (Standard)	3032-8043*	MP05508	White (Special)	80C-10	MP18336						
Vivid Green (Standard)	3032-108*	MP05502**	White*** (Standard)	GC0-10***							
Apple Green*** (Standard)	GC0-180***		Clear*** (Standard)	7735-154***							

\* TO ACHIEVE OPALQUE FINISH FOR CUSTOM TRANSLUCENT VINYL COLORS - APPLY CUSTOM TRANSLUCENT VINYL OVER WHITE OPALQUE SUBSTRATE, 3M 1800-18 W/10 White Panel STD.  
 \*\* TO BE APPLIED OVER 24-48 HOURS WHITE EPOXY PRIMER PER MATTHEWS PAINT COMPANY TO ACHIEVE APPROVED VIVID GREEN COLOR.  
 \*\*\* TO BE USED FOR FABRICATION OF BANK LOGOS AND HARDWARE VINYL ONLY.  
 \*\*\*\* FOR SECOND SURFACE APPLICATION ONLY.



AFTER



BEFORE




SIGN K

D4

QTY - 1

FLOOR - N/A

ADDITIONAL FABRICATION & INSTALLATION NOTES

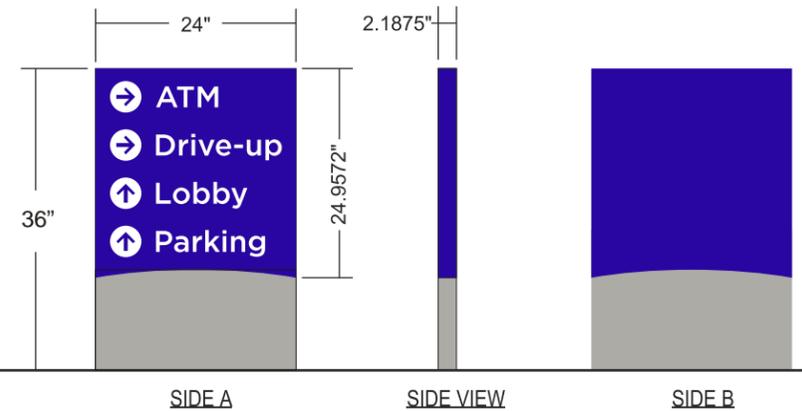

OVERALL BUILDING DIMENSIONS

H = N/A

L = N/A

EXISTING SIGN DIMENSIONS

H = 24"

L = 30.5"

OAH = 48"

SQ FT = 6

ADDITIONAL INFORMATION

**SIGN PANEL:**

- .090 aluminum panel chemically bonded to support tubes.
- To be painted Sapphire Blue MP55619 and Silver Gray MP55607 as illustrated.

**SUPPORT TUBES:**


- 2"x2"x1/8" aluminum tubes.

**COPY:**

- Sign Option: Text
- Graphics and Text to be first surface applied 3M vinyl - White Reflective 680-10.
- Type style to be Gotham-Medium.

**INSTALLATION:**

- Aluminum tubes to be direct buried.

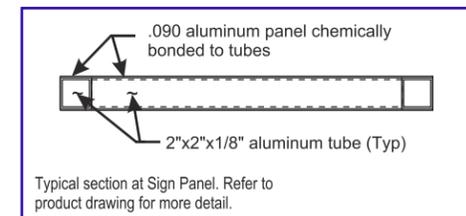

SIDE A  
SIDE B



		9051 EXECUTIVE PARK DR. SUITE 200 KNOXVILLE, TN 37923 OFFICE: 865-539-4001 FAX: 865-539-0851 WWW.LINKENGR.COM		PROJECT SCOPE: <b>EXISTING FACILITY RE-BRAND - OH100486</b>		AFFILIATE: <b>FTCO</b>	
LOCATION: <b>DUBLIN SAWMILL</b>		ADDRESS: <b>3800 WEST DUBLIN GRANVILLE ROAD</b>		CITY, STATE, ZIP: <b>DUBLIN OH 43017</b>		PROJECT #: <b>11-0156</b>	
DRAWING #: <b>G239413R3</b>		ISSUE DATE: <b>09/06/11</b>		APPR: <b>LK</b>		DRAWN BY: <b>BL</b>	
PAGE: <b>14 OF 28</b>		CURRENT REV: <b>3</b>		PROJECT #: <b>11-0156</b>		DRAWN BY: <b>BL</b>	

	3M VINYL	MAP PAINT		3M VINYL	MAP PAINT		3M VINYL	MAP PAINT
	Sapphire Blue (Translucent) 3632-8607	MP55619		White (Diffuser) 3635-70****			Silver Gray (Translucent) 3630-121	MP55607
	Sapphire Blue (Opaque) 180C-37	MP55619		White (Translucent) 3632-20	MP18336		Silver Gray (Opaque) 180C-120	MP55607
	Sapphire Blue*** (Opaque) 7725-37***			White (Opaque) 180C-10	MP18336		Red (Reflective) 680-72	
	Sky Blue (Translucent) 3632-8043*	MP55609		White (Reflective) 680-10	MP18336		Yellow (Reflective) 680-71	
	Vivid Green (Translucent) 3632-156*	MP55605**		White*** (Gerber Foil) GCS-10****			Black (Opaque) 180C-12	MP02281
	Apple Green*** (Gerber Foil) GSC-196***			Clear*** (Translucent) 7725-114****		ALL PAINT TO HAVE SATIN FINISH		

\* TO ACHIEVE OPAQUE FINISH FOR CUSTOM TRANSLUCENT VINYL COLORS - APPLY CUSTOM TRANSLUCENT VINYL OVER WHITE OPAQUE SUBSTRATE. 3M 180C-10 INK, WHITE PAINT, ETC.  
 \*\* TO BE APPLIED OVER 274908-274909 WHITE EPOXY PRIMER PER MATTHEWS PAINT COMPANY TO ACHIEVE APPROVED VIVID GREEN COLOR.  
 \*\*\* TO BE USED FOR FABRICATION OF BANK HOURS AND HANDICAP VINYL ONLY.  
 \*\*\*\* FOR SECOND SURFACE APPLICATION ONLY.

**APPROVED**  
 LINK ENGINEERING, LLC  
 09-06-11

AFTER



BEFORE




SIDE A

SIDE B

**SIGN L**  
**D4**  
**QTY - 1**  
**FLOOR - N/A**

**ADDITIONAL FABRICATION & INSTALLATION NOTES**

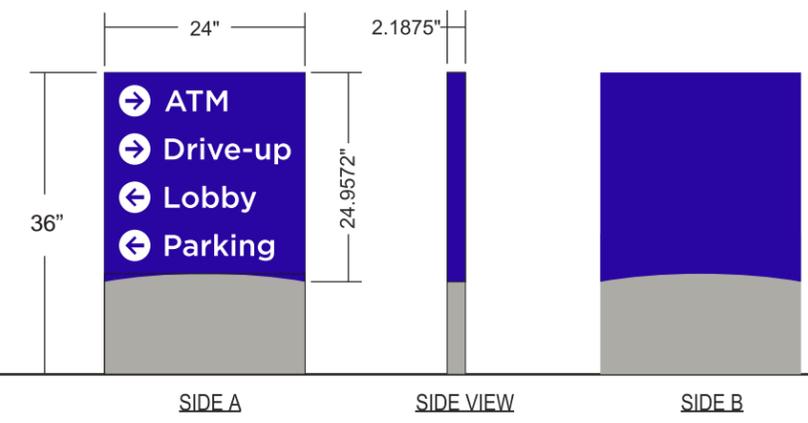

**SIGN PANEL:**

- .090 aluminum panel chemically bonded to support tubes.
- To be painted Sapphire Blue MP55619 and Silver Gray MP55607 as illustrated.

**SUPPORT TUBES:**


- 2"x2"x1/8" aluminum tubes.

**COPY:**

- Sign Option: Text
- Graphics and Text to be first surface applied 3M vinyl - White Reflective 680-10.
- Type style to be Gotham-Medium.

**INSTALLATION:**

- Aluminum tubes to be direct buried.

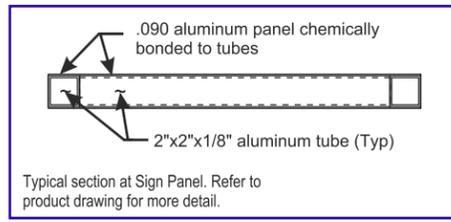

**OVERALL BUILDING DIMENSIONS**

H = N/A

L = N/A

**EXISTING SIGN DIMENSIONS**

H = 24"

L = 30.5"

OAH = 48"

SQ FT = 6

**ADDITIONAL INFORMATION**



		9051 EXECUTIVE PARK DR. SUITE 200 KNOXVILLE, TN 37923 OFFICE: 865-539-4001 FAX: 865-539-0851 WWW.LINKENGR.COM		PROJECT SCOPE: <b>EXISTING FACILITY RE-BRAND - OH100486</b>		AFFILIATE: <b>FTCO</b>	
LOCATION: <b>DUBLIN SAWMILL</b>		ADDRESS: <b>3800 WEST DUBLIN GRANVILLE ROAD</b>		CITY, STATE, ZIP: <b>DUBLIN OH 43017</b>		PROJECT #: <b>11-0156</b>	
DRAWING #: <b>G239413R3</b>		PROJECT #: <b>11-0156</b>		DRAWN BY: <b>BL</b>		REV DATE	
PAGE: <b>15 OF 28</b>		ISSUE DATE: <b>09/06/11</b>		APPR: <b>LK</b>		REV DATE	

REV	DATE	DESCRIPTION OF REVISION	BY	DATE	REVIEW - APPROVAL TYPE	STATUS	BY
4				09/06/11	CLIENT FINAL APPROVAL	<input type="checkbox"/> COMMENTS PROVIDED <input type="checkbox"/> REVISE & RESUBMIT <input type="checkbox"/> APPROVED AS NOTED <input checked="" type="checkbox"/> APPROVED	Fifth Third Bank - JJ
3	09/06/11	Approved per client	SG		LOCAL JURISDICTION PRELIMINARY REVIEW	<input type="checkbox"/> COMMENTS PROVIDED <input type="checkbox"/> REVISE & RESUBMIT <input type="checkbox"/> APPROVED AS NOTED <input type="checkbox"/> APPROVED	
2	08/22/11	Relocate Signs G-I. Relocate Sign W.	SG		OWNER/LL PRELIMINARY APPROVAL	<input type="checkbox"/> COMMENTS PROVIDED <input type="checkbox"/> REVISE & RESUBMIT <input type="checkbox"/> APPROVED AS NOTED <input type="checkbox"/> APPROVED	
1	05/16/11	Revise Signs A, B, C, D and Signs K - O per clients request.	BL	09/06/11	CLIENT PRELIMINARY APPROVAL	<input type="checkbox"/> COMMENTS PROVIDED <input type="checkbox"/> REVISE & RESUBMIT <input type="checkbox"/> APPROVED AS NOTED <input checked="" type="checkbox"/> APPROVED	Fifth Third Bank - JJ

**APPROVED**  
LINK ENGINEERING, LLC  
09-06-11

AFTER




BEFORE



**SIGN M**  
**D4**  
**QTY - 1**  
**FLOOR - N/A**

**ADDITIONAL FABRICATION & INSTALLATION NOTES**

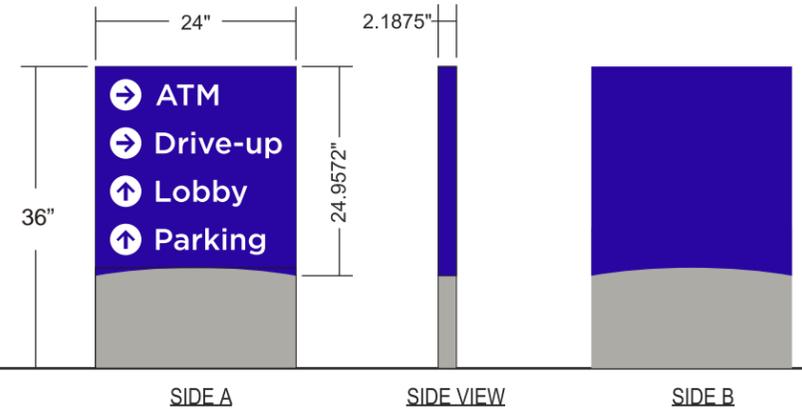

**SIGN PANEL:**

- .090 aluminum panel chemically bonded to support tubes.
- To be painted Sapphire Blue MP55619 and Silver Gray MP55607 as illustrated.

**SUPPORT TUBES:**


- 2"x2"x1/8" aluminum tubes.

**COPY:**

- Sign Option: Text
- Graphics and Text to be first surface applied 3M vinyl - White Reflective 680-10.
- Type style to be Gotham-Medium.

**INSTALLATION:**

- Aluminum tubes to be direct buried.

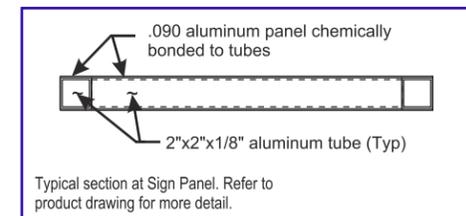

**OVERALL BUILDING DIMENSIONS**

H = N/A

L = N/A

**EXISTING SIGN DIMENSIONS**

H = 24"

L = 30.5"

OAH = 48"

SQ FT = 6


**ADDITIONAL INFORMATION**



9051 EXECUTIVE PARK DR. SUITE 200 KNOXVILLE, TN 37923 OFFICE: 865-539-4001 FAX: 865-539-0851 WWW.LINKENGR.COM		PROJECT SCOPE: <b>EXISTING FACILITY RE-BRAND - OH100486</b> LOCATION: <b>DUBLIN SAWMILL</b> AFFILIATE: <b>FTCO</b> ADDRESS: <b>3800 WEST DUBLIN GRANVILLE ROAD</b> CITY, STATE, ZIP: <b>DUBLIN OH 43017</b> PROJECT #: <b>11-0156</b> DRAWN BY: <b>BL</b>	4 3 2 1	09/06/11 Approved per client SG 08/22/11 Relocate Signs G-I. Relocate Sign W. SG 05/16/11 Revise Signs A, B, C, D and Signs K - O per clients request. BL	09/06/11 CLIENT FINAL APPROVAL LOCAL JURISDICTION PRELIMINARY REVIEW OWNER/LL PRELIMINARY APPROVAL 09/06/11 CLIENT PRELIMINARY APPROVAL	<input type="checkbox"/> COMMENTS PROVIDED <input type="checkbox"/> REVISE & RESUBMIT <input type="checkbox"/> APPROVED AS NOTED <input checked="" type="checkbox"/> APPROVED	Fifth Third Bank - JU
PAGE: <b>16 OF 28</b> CURRENT REV: <b>3</b>	DRAWING #: <b>G239413R3</b> ISSUE DATE: <b>09/06/11</b> APPR: <b>LK</b>	PROJECT #: <b>11-0156</b> DRAWN BY: <b>BL</b>	REV DATE DESCRIPTION OF REVISION BY DATE REVIEW - APPROVAL TYPE STATUS BY	REVIEW - APPROVAL TYPE STATUS BY	REVIEW - APPROVAL TYPE STATUS BY	REVIEW - APPROVAL TYPE STATUS BY	REVIEW - APPROVAL TYPE STATUS BY

**APPROVED**  
 LINK ENGINEERING, LLC  
 09-06-11

AFTER

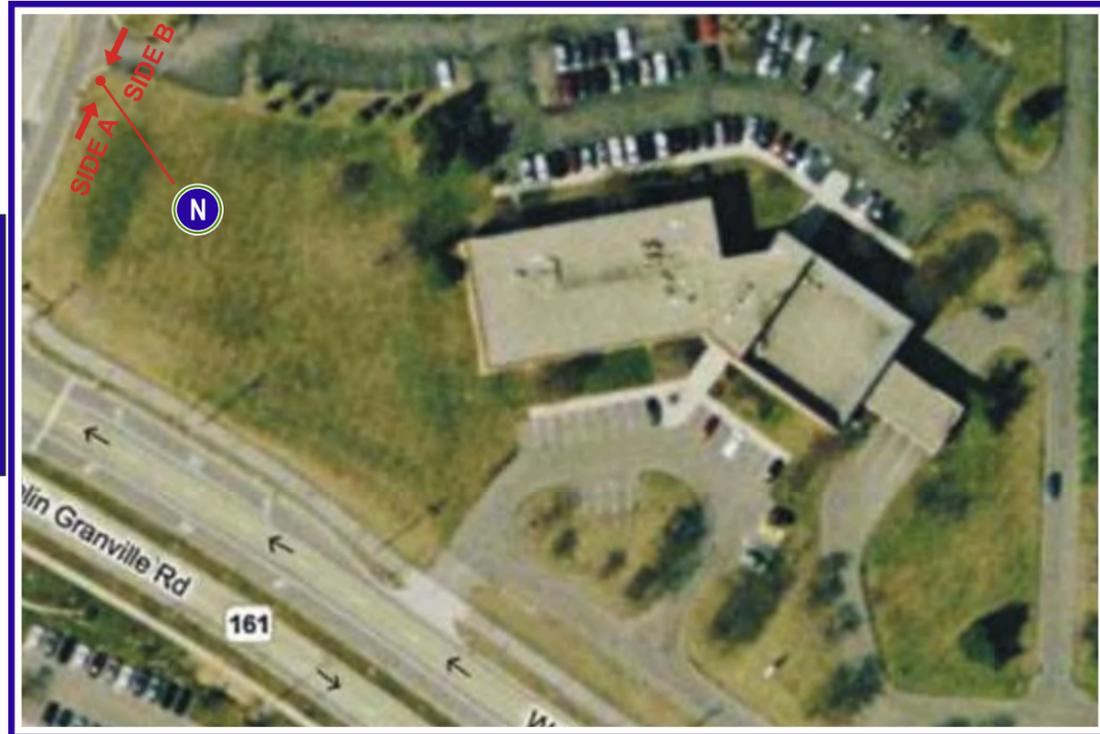

BEFORE



2 SQ FT REGULATORY @ 3' OAH

SIGN N

R36

QTY - 1

FLOOR - N/A

ADDITIONAL FABRICATION & INSTALLATION NOTES

OVERALL BUILDING DIMENSIONS

H = N/A

L = N/A

EXISTING SIGN DIMENSIONS


H = 24"

L = 30.5"

OAH = 48"

SQ FT = 6

ADDITIONAL INFORMATION

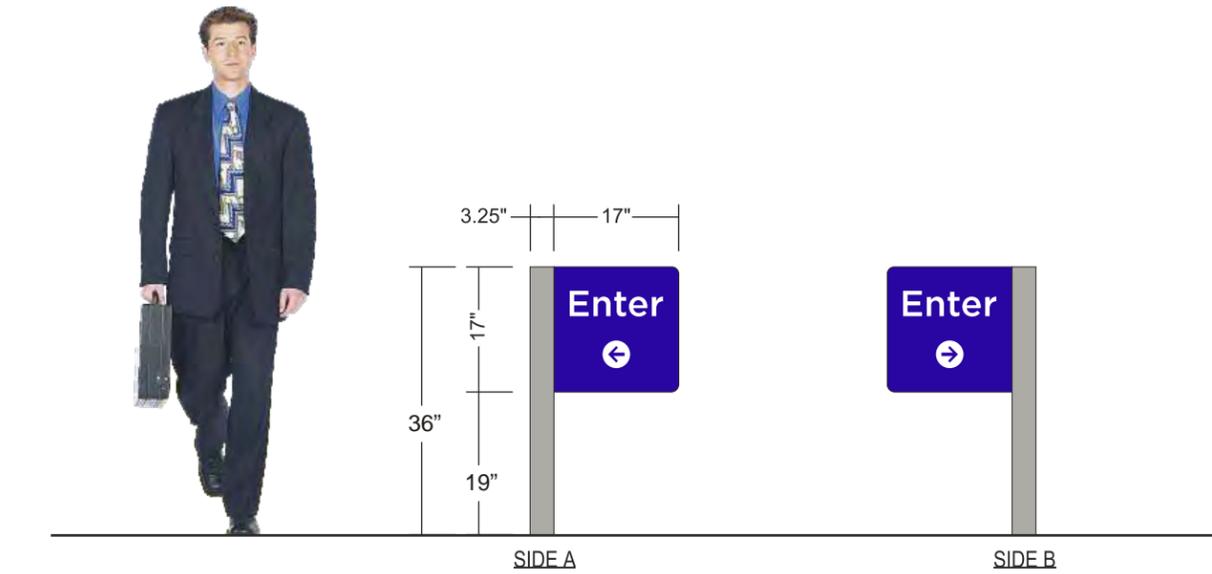

**SIGN PANEL:**

- .190 aluminum panel.
- All to be painted Sapphire Blue MP55619.

**SIGN POST:**


- SignComp Architectural Sign Post (#1005) with SignComp Post Cap (#5252).
- To be painted Silver Gray MP55607.

**COPY:**

- Graphics and Text to be first surface applied 3M vinyl - White Reflective 680-10.
- Type style to be Gotham-Medium.

**INSTALLATION:**

- Extruded aluminum post to be direct buried.

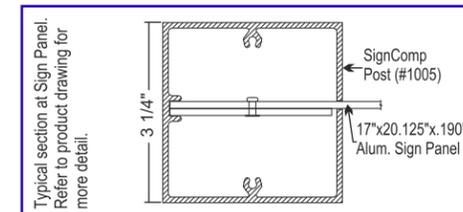

		9051 EXECUTIVE PARK DR. SUITE 200 KNOXVILLE, TN 37923 OFFICE: 865-539-4001 FAX: 865-539-0851 WWW.LINKENGR.COM		PROJECT SCOPE: <b>EXISTING FACILITY RE-BRAND - OH100486</b>		AFFILIATE: <b>FTCO</b>	
PAGE: 17 OF 28 CURRENT REV: 3		DRAWING #: <b>G239413R3</b> ISSUE DATE: <b>09/06/11</b> APPR: <b>LK</b>		LOCATION: <b>DUBLIN SAWMILL</b>		ADDRESS: <b>3800 WEST DUBLIN GRANVILLE ROAD</b>	
CITY, STATE, ZIP: <b>DUBLIN OH 43017</b>		PROJECT #: <b>11-0156</b>		DRAWN BY: <b>BL</b>			

	3M VINYL	MAP PAINT		3M VINYL	MAP PAINT	3M VINYL	MAP PAINT	
	Sapphire Blue (Translucent) 3632-8607	MP55619		White (Diffuser) 3635-70****			Silver Gray (Translucent) 3630-121	MP55607
	Sapphire Blue (Opaque) 180C-37	MP55619		White (Translucent) 3632-20	MP18336		Silver Gray (Opaque) 180C-120	MP55607
	Sapphire Blue*** (Opaque) 7725-37***			White (Opaque) 180C-10	MP18336		Red (Reflective) 680-72	
	Sky Blue (Translucent) 3632-8043*	MP55609		White (Reflective) 680-10	MP18336		Yellow (Reflective) 680-71	
	Vivid Green (Translucent) 3632-156*	MP55605**		White*** (Gerber Foil) GCS-10****			Black (Opaque) 180C-12	MP02281
	Apple Green*** (Gerber Foil) GSC-196***			Clear*** (Translucent) 7725-114****		ALL PAINT TO HAVE SATIN FINISH		

**APPROVED**  
 LINK ENGINEERING, LLC  
 09-06-11

\* TO ACHIEVE OPAQUE FINISH FOR CUSTOM TRANSLUCENT VINYL COLORS - APPLY CUSTOM TRANSLUCENT VINYL OVER WHITE OPAQUE SUBSTRATE. 3M 180C-10 ONLY, WHITE PAINT, ETC.  
 \*\* TO BE APPLIED OVER 274908-274909 WHITE EPOXY PRIMER PER MATTHEWS PAINT COMPANY TO ACHIEVE APPROVED VIVID GREEN COLOR.  
 \*\*\* TO BE USED FOR FABRICATION OF BANK HOURS AND HANDICAP VINYL ONLY.  
 \*\*\*\* FOR SECOND SURFACE APPLICATION ONLY.

**SIGN O**  
**REMOVE**  
**QTY - 1**  
**FLOOR - N/A**

**ADDITIONAL FABRICATION & INSTALLATION NOTES**

# REMOVE ONLY



**OVERALL BUILDING DIMENSIONS**

H = N/A  
L = N/A

**EXISTING SIGN DIMENSIONS**

H = 26"  
L = 24"  
OAH = 48"  
SQ FT = 4

**ADDITIONAL INFORMATION**



 9781 EXECUTIVE PARK DR. SUITE 300 KNOXVILLE, TN 37922 PHONE 615-522-6600 WWW.LINKSIGNAL.COM		<b>PROJECT SCOPE:</b> EXISTING FACILITY RE-BRAND - OH100488 <b>LOCATION:</b> DUBLIN SAWNELL <b>APPROVE:</b> FTCO <b>ADDRESS:</b> 3899 WEST DUBLIN GRANVILLE ROAD <b>CITY, STATE, ZIP:</b> DUBLIN OH 43017 <b>PROJECT #:</b> 11-0188 <b>ISSUE DATE:</b> 09/08/11 <b>APPV:</b> LK <b>REVISION #:</b> 3 <b>CURRENT REV:</b> 3	
---	--	---	--

3M VINYL		MAP PAINT		3M VINYL		MAP PAINT		3M VINYL		MAP PAINT	
	Sapphire Blue (Standard)	3032-9007	MP00019		White (Standard)	3030-70***	MP18336		Silver Gray (Standard)	3030-121	MP00007
	Sapphire Blue*** (Special)	180C-37	MP00010		White (Standard)	3032-30	MP18336		Silver Gray (Special)	180C-120	MP00007
	Sky Blue*** (Special)	7755-87***			White (Standard)	180C-10	MP18336		Red (Standard)	600-72	
	Vivid Green (Standard)	3032-8043**	MP00008		White (Standard)	800-10	MP18336		Yellow (Standard)	600-71	
	Apple Green*** (Standard)	3032-108*	MP00009**		White*** (Standard)	000-10***			Black (Special)	180C-12	MP02201
		05C-180***			Clear*** (Standard)	7735-154***					

\*\*\* TO BE USED FOR FABRICATION OF BANK LOGOS AND HANDCAP VINYL ONLY.  
 \*\* FOR SECOND SURFACE APPLICATION ONLY.

**APPROVED**  
 LINK E. HERRING, LLC  
 09-08-11

AFTER



BEFORE



2 SQ FT REGULATORY @ 3' OAH


SIGN P

R36

QTY - 1

FLOOR - N/A

ADDITIONAL FABRICATION & INSTALLATION NOTES

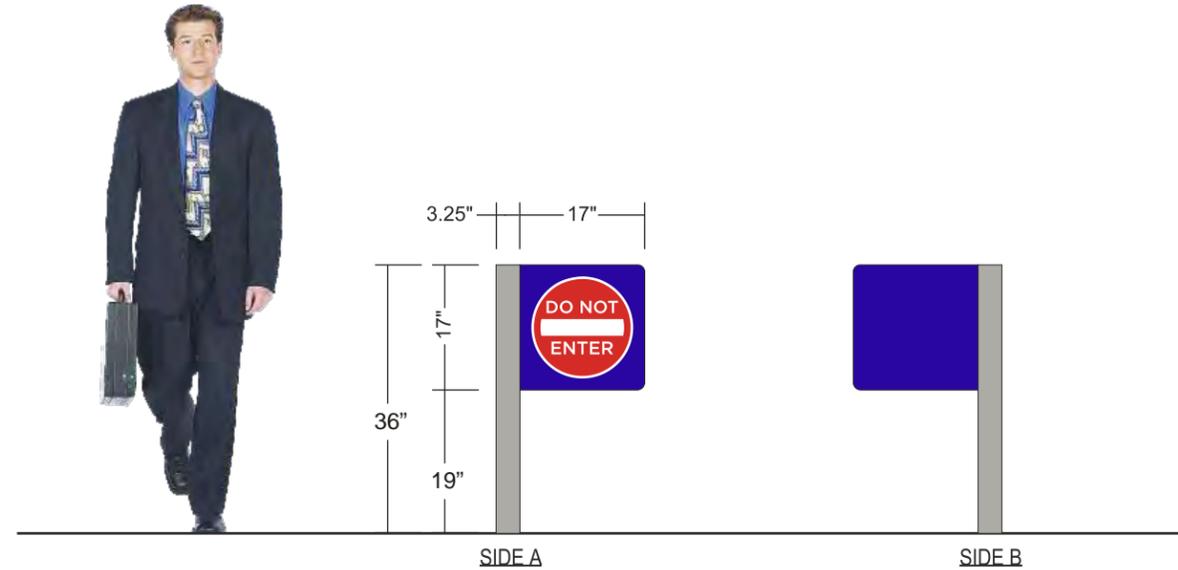

**SIGN PANEL:**

- .190 aluminum panel.
- All to be painted Sapphire Blue MP55619.

**INSTALLATION:**


- Extruded aluminum post to be direct buried.

**SIGN POST:**

- SignComp Architectural Sign Post (#1005) with SignComp Post Cap (#5252).
- To be painted Silver Gray MP55607.

**COPY:**

- Graphics to be first surface applied 3M vinyls - White Reflective 680-10 and Red Reflective 680-72.
- Text to be first surface applied 3M vinyl - White Reflective 680-10.
- Type style to be Gotham-Medium.

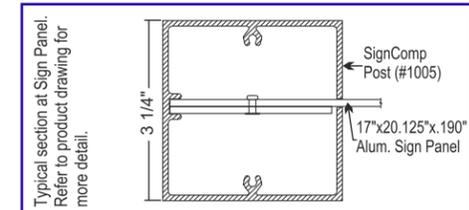

**OVERALL BUILDING DIMENSIONS**

H = N/A

L = N/A

**EXISTING SIGN DIMENSIONS**

H = 24"

L = 30.5"

OAH = 48"

SQ FT = 6

**ADDITIONAL INFORMATION**



		9051 EXECUTIVE PARK DR. SUITE 200 KNOXVILLE, TN 37923 OFFICE: 865-539-4001 FAX: 865-539-0851 WWW.LINKENGR.COM		PROJECT SCOPE: <b>EXISTING FACILITY RE-BRAND - OH100486</b>		AFFILIATE: <b>FTCO</b>	
PAGE: <b>19 OF 28</b> CURRENT REV: <b>3</b>		DRAWING #: <b>G239413R3</b> ISSUE DATE: <b>09/06/11</b>		LOCATION: <b>DUBLIN SAWMILL</b>		ADDRESS: <b>3800 WEST DUBLIN GRANVILLE ROAD</b>	
CITY, STATE, ZIP: <b>DUBLIN OH 43017</b>		PROJECT #: <b>11-0156</b>		DRAWN BY: <b>BL</b>			

	3M VINYL	MAP PAINT		3M VINYL	MAP PAINT		3M VINYL	MAP PAINT
	Sapphire Blue (Translucent) 3632-8607	MP55619		White (Diffuser) 3635-70****			Silver Gray (Translucent) 3630-121	MP55607
	Sapphire Blue (Opaque) 180C-37	MP55619		White (Translucent) 3632-20	MP18336		Silver Gray (Opaque) 180C-120	MP55607
	Sapphire Blue*** (Opaque) 7725-37***			White (Opaque) 180C-10	MP18336		Red (Reflective) 680-72	
	Sky Blue (Translucent) 3632-8043*	MP55609		White (Reflective) 680-10	MP18336		Yellow (Reflective) 680-71	
	Vivid Green (Translucent) 3632-156*	MP55605**		White*** (Gerber Foil) GCS-10****			Black (Opaque) 180C-12	MP02281
	Apple Green*** (Gerber Foil) GSC-196***			Clear*** (Translucent) 7725-114****		ALL PAINT TO HAVE SATIN FINISH		

\* TO ACHIEVE OPAQUE FINISH FOR CUSTOM TRANSLUCENT VINYL COLORS - APPLY CUSTOM TRANSLUCENT VINYL OVER WHITE OPAQUE SUBSTRATE. 3M 180C-10 INK, WHITE PAINT, ETC.

\*\* TO BE APPLIED OVER 274908-274909 WHITE EPOXY PRIMER PER MATTHEWS PAINT COMPANY TO ACHIEVE APPROVED VIVID GREEN COLOR.

\*\*\* TO BE USED FOR FABRICATION OF BANK HOURS AND HANDICAP VINYL ONLY.

\*\*\*\* FOR SECOND SURFACE APPLICATION ONLY.

**APPROVED**  
 LINK ENGINEERING, LLC  
 09-06-11

AFTER



2 SQ FT REGULATORY @ 3' OAH


SIGN Q

R36

QTY - 1

FLOOR - N/A

ADDITIONAL FABRICATION & INSTALLATION NOTES

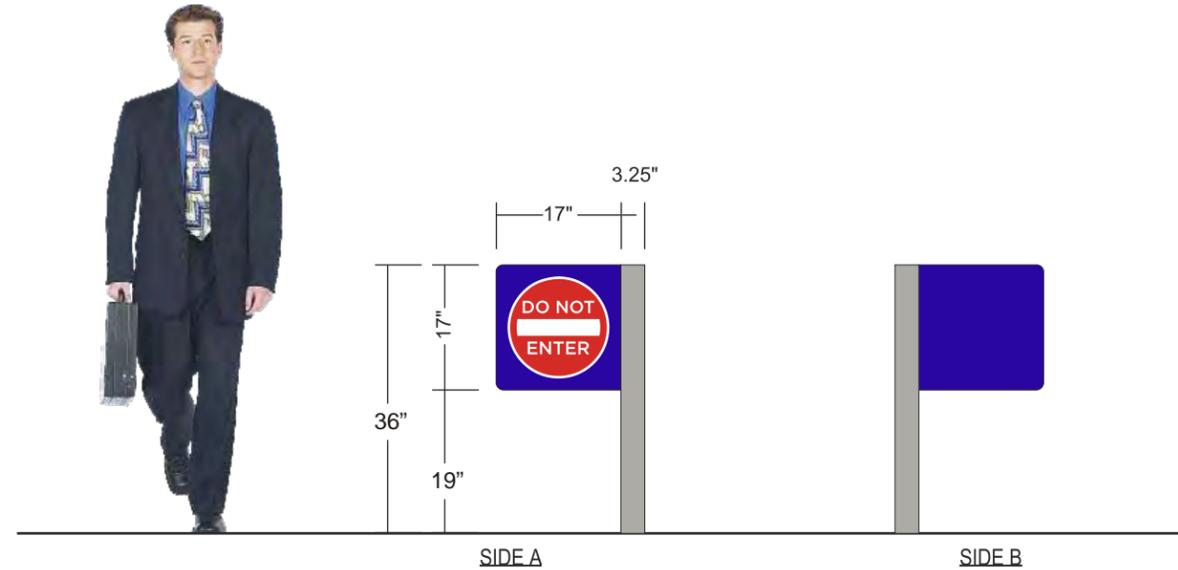

**SIGN PANEL:**

- .190 aluminum panel.
- All to be painted Sapphire Blue MP55619.

**INSTALLATION:**


- Extruded aluminum post to be direct buried.

**SIGN POST:**

- SignComp Architectural Sign Post (#1005) with SignComp Post Cap (#5252).
- To be painted Silver Gray MP55607.

**COPY:**

- Graphics to be first surface applied 3M vinyls - White Reflective 680-10 and Red Reflective 680-72.
- Text to be first surface applied 3M vinyl - White Reflective 680-10.
- Type style to be Gotham-Medium.

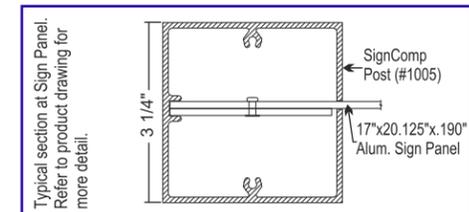

**OVERALL BUILDING DIMENSIONS**

H = N/A

L = N/A

**EXISTING SIGN DIMENSIONS**

H = N/A

L = N/A

OAH = N/A

SQ FT = N/A

**ADDITIONAL INFORMATION**



		9051 EXECUTIVE PARK DR. SUITE 200 KNOXVILLE, TN 37923 OFFICE: 865-539-4001 FAX: 865-539-0851 WWW.LINKENGR.COM		PROJECT SCOPE: <b>EXISTING FACILITY RE-BRAND - OH100486</b>		AFFILIATE: <b>FTCO</b>	
LOCATION: <b>DUBLIN SAWMILL</b>		ADDRESS: <b>3800 WEST DUBLIN GRANVILLE ROAD</b>		CITY, STATE, ZIP: <b>DUBLIN OH 43017</b>		PROJECT #: <b>11-0156</b>	
PAGE: <b>20 OF 28</b>		DRAWING #: <b>G239413R3</b>		DRAWN BY: <b>BL</b>		CURRENT REV: <b>3</b>	
ISSUE DATE: <b>09/06/11</b>		APPR: <b>LK</b>		PROJECT #: <b>11-0156</b>		DRAWN BY: <b>BL</b>	

	3M VINYL	MAP PAINT		3M VINYL	MAP PAINT		3M VINYL	MAP PAINT
	Sapphire Blue (Translucent) 3632-8607	MP55619		White (Diffuser) 3635-70****			Silver Gray (Translucent) 3630-121	MP55607
	Sapphire Blue (Opaque) 180C-37	MP55619		White (Translucent) 180C-20	MP18336		Silver Gray (Opaque) 180C-120	MP55607
	Sapphire Blue*** (Opaque) 7725-37***			White (Opaque) 180C-10	MP18336		Red (Reflective) 680-72	
	Sky Blue (Translucent) 3632-8043*	MP55609		White (Reflective) 680-10	MP18336		Yellow (Reflective) 680-71	
	Vivid Green (Translucent) 3632-156*	MP55605**		White*** (Gerber Foil) GCS-10***			Black (Opaque) 180C-12	MP02281
	Apple Green*** (Gerber Foil) GSC-196***			Clear*** (Translucent) 7725-114***		<b>ALL PAINT TO HAVE SATIN FINISH</b>		

\* TO ACHIEVE OPAQUE FINISH FOR CUSTOM TRANSLUCENT VINYL COLORS - APPLY CUSTOM TRANSLUCENT VINYL OVER WHITE OPAQUE SUBSTRATE. 3M 180C-10 INK, WHITE PAINT, ETC.

\*\* TO BE APPLIED OVER 274908-274909 WHITE EPOXY PRIMER PER MATTHEWS PAINT COMPANY TO ACHIEVE APPROVED VIVID GREEN COLOR.

\*\*\* TO BE USED FOR FABRICATION OF BANK HOURS AND HANDICAP VINYL ONLY.

\*\*\*\* FOR SECOND SURFACE APPLICATION ONLY.

**APPROVED**  
 LINK ENGINEERING, LLC  
 09-06-11


AFTER



BEFORE



1 SQ FT REGULATORY WALL PANEL - CLEARANCE

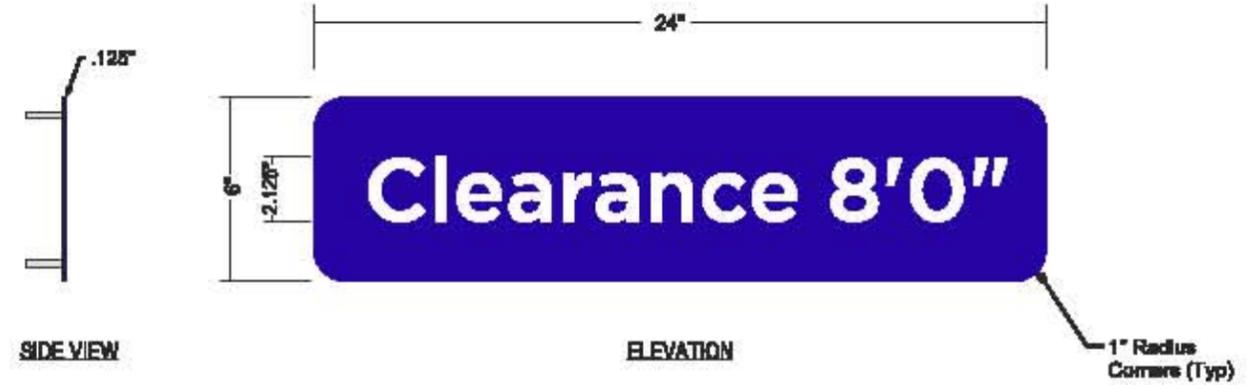

**SIGN R**  
**R1WP-CL**  
**QTY - 4**  
**FLOOR - N/A**

**ADDITIONAL FABRICATION & INSTALLATION NOTES**

**PATCH, PAINT, AND REPAIR FASCIA AS REQUIRED.**

**Overall Building Dimensions**

H = 26'-9"

L = 97'-0"

**Existing Sign Dimensions**

H = 12"

L = 48"

GAH = N/A

SQ FT = 4

**ADDITIONAL INFORMATION**

**SIGN PANEL:**

- .125 aluminum panel
- All to be painted Sapphire Blue MP55819.

**COPY:**

- Text to be first surface applied 3M vinyl - White Reflective 880-10.
- Type style to be Gotham-Medium.

**INSTALLATION:**

- Mounted with 1/4" fasteners as required.



208 E EXECUTIVE PARK DR.  
SUITE 800  
DUBLIN, OH 43003  
PHONE 614-885-4001  
FAX 614-885-2881  
WWW.FTBANK.COM

Page: 21 of 26  
Current Rev: 3

PROJECT CODE: EXISTING FACILITY RE-BRAND - OH108488  
LOCATION: DUBLIN BARNELL  
ADDRESS: 3600 WEST DUBLIN GRANVILLE ROAD  
CITY, STATE, ZIP: DUBLIN OH 43017  
PROJECT #: 11-0150  
APPROVED BY: FTCO  
DESIGNED BY: BL

	3M VINYL	MAP PAINT		3M VINYL	MAP PAINT		3M VINYL	MAP PAINT
Sapphire Blue	(Translucent) 2632-8807	MP55819	White	(Opaque) 2635-70	MP18338	Silver Gray	(Translucent) 3030-121	MP55807
Sapphire Blue	(Opaque) 1900-37	MP55819	White	(Translucent) 2632-20	MP18338	Silver Gray	(Opaque) 1800-120	MP55807
Sapphire Blue***	(Opaque) 7720-37***	MP55800	White	(Opaque) 1800-10	MP18338	Red	(Opaque) 880-72	MP55807
Sky Blue	(Translucent) 2635-8543*	MP55800	White	(Yellow) 880-10	MP18338	Yellow	(Opaque) 880-71	MP55807
Vivid Green	(Translucent) 2635-185*	MP55800**	White***	(Dark Red) GCS-10**		Black	(Opaque) 1800-12	MP52281
Apple Green***	(Opaque) G8C-108**		Clear***	(Translucent) 7725-116**				

\* TO ACHIEVE ORANGE FINISH FOR CUSTOM TRANSLUCENT VINYL COLORS - APPLY CUSTOM TRANSLUCENT VINYL OVER WHITE OPALQUE SUBSTRATE 3M 180C-10 Ink, Maroon, ETC.  
\*\* TO BE APPLIED OVER STAINLESS STEEL BRUSH FINISH PER MATTHEW PAINT COMPANY TO ACHIEVE APPROVED VIVID GREEN COLOR.  
\*\*\* TO BE USED FOR FABRICATION OF BANK HOUSES AND MARQUEE VINYL ONLY.  
\*\*\* FOR SECOND SURFACE APPLICATION ONLY.

**APPROVED**  
LINK & ASSOCIATES, LLC  
02-06-11


AFTER



BEFORE



1 SQ FT REGULATORY WALL PANEL - ATM

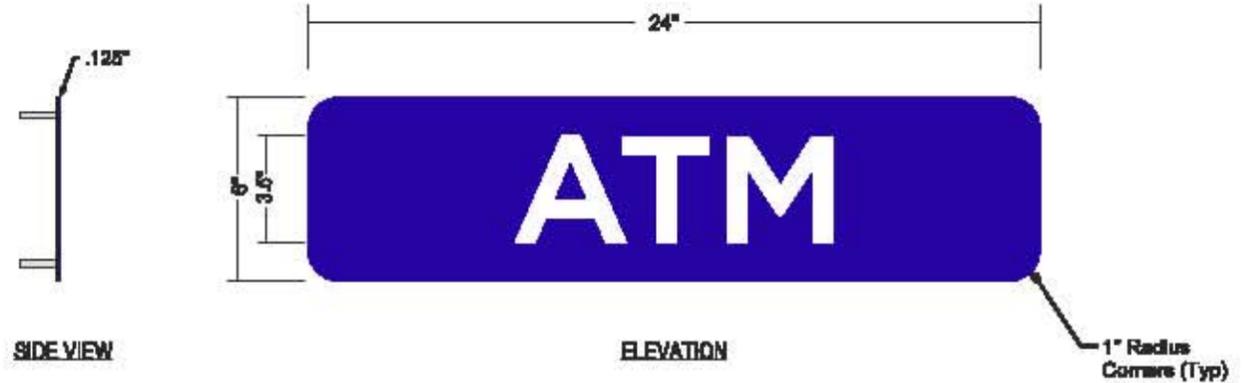

**SIGN 5**  
**R1WP-ATM**  
**QTY - 1**  
**FLOOR - N/A**

**ADDITIONAL FABRICATION & INSTALLATION NOTES**

**PATCH, PAINT, AND REPAIR FASCIA AS REQUIRED.**

**Overall Building Dimensions**

H = 26'-9"  
 L = 97'-0"

**Existing Sign Dimensions**

H = 6"  
 L = 24"

GAH = N/A

SQ FT = 1

**ADDITIONAL INFORMATION**

**SIGN PANEL:**

- .125 aluminum panel
- All to be painted Sapphire Blue MP55819.

**COPY:**

- Text to be first surface applied 3M vinyl - White Reflective 880-10.
- Type style to be Gotham-Medium.

**INSTALLATION:**

- Mounted with 1/4" fasteners as required.



		1081 EXECUTIVE PARK DR. SUITE 800 DUBLIN, OH 43003 PHONE 614-885-4001 FAX 614-885-2881 WWW.FIFTHTHIRD.COM		<b>PROJECT CODE:</b> EXISTING FACILITY RE-BRAND - OH108488 <b>LOCATION:</b> DUBLIN BARNELL <b>ADDRESS:</b> 3600 WEST DUBLIN GRANVILLE ROAD <b>CITY, STATE, ZIP:</b> DUBLIN OH 43017 <b>PROJECT #:</b> 11-0150 <b>DATE:</b> 09/06/11 <b>APP'D:</b> LK <b>DRAWN BY:</b> BL		<b>ARRANGER:</b> FTCCO
Page: 22 OF 26 Current Rev: 3	Drawing #: G228413813 Issue Date: 09/06/11					

3M VINYL		MAP PAINT		3M VINYL		MAP PAINT		3M VINYL		MAP PAINT	
Sapphire Blue	(Translucent)	2832-8807	MP55819	White	(Opaque)	2835-70	MP18338	Silver Gray	(Translucent)	3030-121	MP08807
Sapphire Blue	(Opaque)	1900-37	MP88019	White	(Translucent)	2832-20	MP18338	Silver Gray	(Opaque)	1800-120	MP08807
Sapphire Blue***	(Opaque)	7720-37***	MP88000	White	(Opaque)	1800-10	MP18338	Red	(Opaque)	880-72	MP08807
Sky Blue	(Translucent)	2835-8543*	MP88600	White	(Yellow)	880-10	MP18338	Yellow	(Opaque)	880-71	MP08807
Vivid Green*	(Translucent)	2835-185*	MP88606**	White***	(Dark Red)	GCS-10**		Black	(Opaque)	1800-12	MP02201
Apple Green***	(Opaque)	G8C-108**		Clear***		7725-116**					

\* TO ACHIEVE ORANGE FINISH FOR CUSTOM TRANSLUCENT VINYL COLORS - APPLY CUSTOM TRANSLUCENT VINYL OVER WHITE OPALQUE SUBSTRATE 3M 180C-10 Ink, UltraFrag, ETC.  
 \*\* TO BE APPLIED OVER STAINLESS STEEL BRUSHED FINISH. MATHEWS PAINT COMPANY TO ACHIEVE APPROVED VIVID GREEN COLOR.  
 \*\*\* TO BE USED FOR FABRICATION OF BANK HOUSES AND MARKING VINYL ONLY. \*\* FOR SECOND SURFACE APPLICATION ONLY.

**APPROVED**  
 LINK C. HARRISON, LLC  
 08-06-11


AFTER



BEFORE



**2 SQ FT DRIVE-UP BANKING HOURS PANEL**

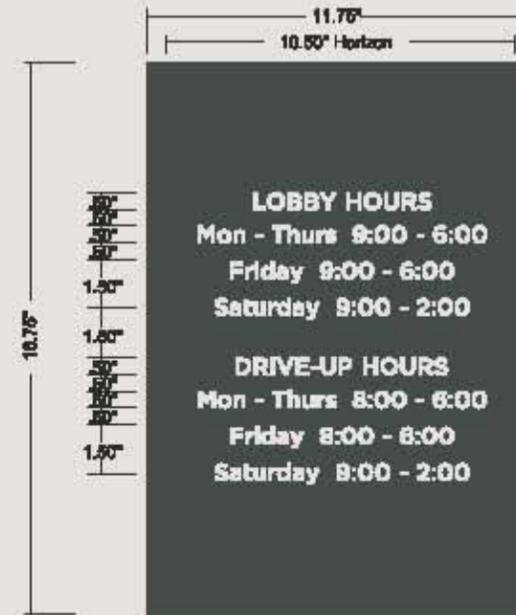

FRONT

**NOTE**

Banking hours shown for example only.  
Verify actual banking hours prior to manufacturing.

**DRIVE-UP PANEL LOCATED INSIDE DRIVE-UP WINDOW - NOT MOUNTED TO GLASS**

**DRIVE-UP PANEL:**

- Sign Panel to be .125" thick white acrylic with first surface applied Vinyl Banking Hours Panel (Front Only).

**VINYL BANKING HOURS PANEL:**  
FRONT

- Background Panel to be 3M vinyl- Opaque Sapphire Blue 7725-37.
- Horizon/Shield Logo and Logo Copy to be Gerber Apple Green Foil GCS-198 and Gerber White Foil GCS-10.
- Text to be Gerber White Foil GCS-10.
- Rules to be Gerber Apple Green Foil GCS-198.
- Type style to be Gotham-Medium.

**VINYL PLACEMENT DETAIL**



\*TO BE PLACED IN LOWER LEFT HAND CORNER OF DRIVE UP GLASS

**SIGN T**

**VP-DU**

**QTY - 1**

**FLOOR - N/A**

**ADDITIONAL FABRICATION & INSTALLATION NOTES**

SEE ILLUSTRATION FOR SIGN PLACEMENT

**OVERALL BUILDING DIMENSIONS**

H = 25'-0"

L = 97'-0"

**EXISTING SIGN DIMENSIONS**

H = 18.75"

L = 11.75"

OAH = N/A

SQ FT = 2

**ADDITIONAL INFORMATION**



		PROJECT SCOPE: <b>EXISTING FACILITY RE-BRAND - OH100486</b>	
9081 EXECUTIVE PARK DR. SUITE 300 CINCINNATI, OH 45240 PHONE 513-962-1234 WWW.FIFTHTHIRD.COM	WORKSHEET: <b>DUBLIN SMMELL</b>	APPROVE: <b>FTCO</b>	
PAGE: <b>23 of 28</b> CURRENT REV: <b>3</b>	SHEET #: <b>Q238413R3</b> DATE: <b>09/08/11</b>	ADDRESS: <b>3889 WEST DUBLIN @ GRANVILLE ROAD</b> CITY, STATE, ZIP: <b>DUBLIN OH 43017</b>	DRAWN BY: <b>11-0186</b>
			REVISION: <b>BL</b>

3M VINYL		MAP PAINT		3M VINYL		MAP PAINT		3M VINYL		MAP PAINT			
Sapphire Blue (Standard)	3032-9007	MP00019	White (Standard)	3030-70***	Silver Gray (Standard)	3030-121	MP00007	Sapphire Blue (Standard)	180C-37	MP00010	Silver Gray (Standard)	180C-120	MP00007
Sapphire Blue*** (Standard)	7725-37***		White (Standard)	180C-10	MP18338	Red (Standard)	600-72		Sky Blue (Standard)	3032-9043**	MP18338	600-71	
Sky Blue (Standard)	3032-9043**	MP18338	White (Standard)	88C-10	MP18338	Yellow (Standard)	600-71		Vivid Green (Standard)	3032-108*	MP18338**	180C-12	MP02201
Apple Green*** (Standard)	7725-154***		White*** (Standard)	7725-154***		Black (Standard)	180C-12	MP02201	Apple Green*** (Standard)	GSC-189***			

\* TO ACHIEVE OPAQUE FINISH FOR CUSTOM TRANSLUCENT VINYL COLORS - APPLY CUSTOM TRANSLUCENT VINYL OVER WHITE OPAQUE SUBSTRATE, 3M 180C-10 Ink, 180C-12 Ink, ETC.  
 \*\* TO BE APPLIED OVER 27486, 27488 WHITE EPICOL PRIMER FOR MATTERING PAINT COMPANY TO ACHIEVE APPROVED VIVID GREEN COLOR.  
 \*\*\* TO BE USED FOR FABRICATION OF BANK HOURS AND MARIAGE VINYL ONLY.  
 \*\*\*\* FOR SECOND SURFACE APPLICATION ONLY.




AFTER



BEFORE



1 SQ FT REGULATORY WALL PANEL - NIGHT DEPOSITORY

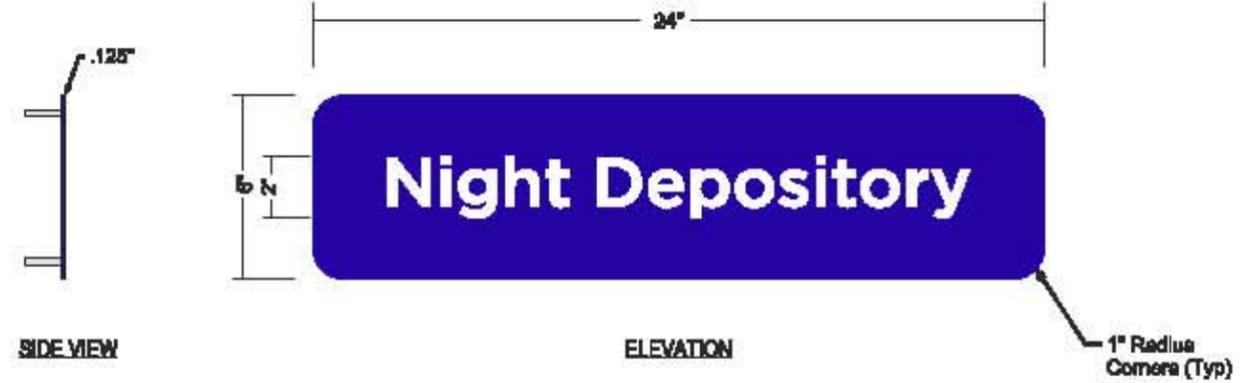

**SIGN U**  
**R1WP-ND**  
**QTY - 1**  
**FLOOR - N/A**

**ADDITIONAL FABRICATION & INSTALLATION NOTES**

**OVERALL BUILDING DIMENSIONS**


H = 25'-0"  
 L = 97'-0"

**EXISTING SIGN DIMENSIONS**

H = N/A  
 L = N/A  
 OAH = N/A  
 SQ FT = N/A

**ADDITIONAL INFORMATION**

- SIGN PANEL:**
- .125 aluminum panel
  - All to be painted Sapphire Blue MP55818.
- COPY:**
- Text to be first surface applied 3M vinyl-White Reflective 600-10.
  - Type style to be Gotham-Medium.
- INSTALLATION:**
- Mounted with 1/4" fasteners as required.

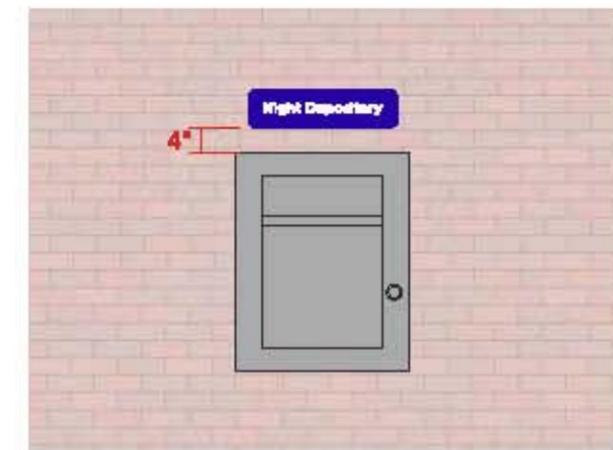

<p>2061 EXECUTIVE PLAZA DR          SUITE 500          CINCINNATI, OH 45240          PHONE 513-964-5000          WWW.LINCOLN-DESIGN.COM</p>		<p><b>PROJECT SCOPE:</b> EXISTING FACILITY RE-BRAND - OH100486</p> <p><b>LOCATION:</b> DUBLIN SAWNELL</p> <p><b>ADDRESS:</b> 3890 WEST DUBLIN GRANVILLE ROAD</p> <p><b>CITY, STATE, ZIP:</b> DUBLIN OH 43017</p> <p><b>PROJECT #:</b> 11-0158</p>		<p><b>CLIENT:</b> FTCC</p> <p><b>DATE:</b> 09/06/11</p> <p><b>DESIGNER:</b> LK</p> <p><b>DATE:</b> 11-0158</p>
---	--	---	--	--

3M VINYL		MAP PAINT		3M VINYL		MAP PAINT	
Sapphire Blue (Standard)	2822-6807	White (Flat)	3635-70****	Silver Gray (Standard)	3635-121	White (Flat)	3635-70****
Sapphire Blue (Gloss)	1800-37	White (Gloss)	3635-20	Silver Gray (Gloss)	1800-120	White (Gloss)	3635-20
Sapphire Blue*** (Gloss)	7725-57***	White (Satin)	1600-10	Red (Flat)	680-73	White (Satin)	1600-10
Sky Blue (Standard)	3482-6043**	White (Satin)	660-10	Red (Gloss)	680-71	White (Satin)	660-10
Sky Blue (Gloss)	3482-196*	White (Satin)	GCC-10***	Yellow (Flat)	1800-12	White (Satin)	GCC-10***
Vivid Green (Standard)	3482-196*	White (Satin)	7725-114***	Yellow (Gloss)		White (Satin)	7725-114***
Vivid Green (Gloss)	GSC-196**	Clear*** (Standard)		Black (Flat)		Clear*** (Standard)	

**ALL COLORS TO BE USED AS SHOWN**

\*\*\* TO BE USED FOR FABRICATION OF BANK HOURS AND HANDBOOK VENTILE ONLY. FOR SECOND SURFACE APPLICATION ONLY.

**APPROVED**  
 LINK & PARTNERS, LLC  
 09-06-11

**SIGN V**  
**ATM**  
**QTY - 1**  
**FLOOR - N/A**

**ADDITIONAL FABRICATION & INSTALLATION NOTES**

**ATM TO BE PAINTED ONSITE**

# ATM REBRAND



**ATM REBRAND INFORMATION TO BE PROVIDED BY FIFTH THIRD BANK ATM DEPARTMENT AT A LATER DATE.**

**OVERALL ATM DIMENSIONS**

H = N/A

L = N/A

**EXISTING ATM DIMENSIONS**

H = 64.75"

L = 69.625"

OAH = N/A

SQ FT = N/A

**ADDITIONAL INFORMATION**



		<b>PROJECT SCOPE:</b> EXISTING FACILITY RE-BRAND - OH100486	
9781 EXECUTIVE PARK DR. SUITE 300 KNOXVILLE, TN 37922 PHONE: 615-529-4400 WWW.FIFTHTHIRD.COM		<b>LOCATION:</b> DUBLIN SAWNELL	<b>APPLIC:</b> FTCO
<b>FIG:</b> 25 of 28 <b>CURRENT REV:</b> 3		<b>ADDRESS:</b> 3899 WEST DUBLIN GRANVILLE ROAD DUBLIN OH 43017	
<b>ISSUE #:</b> Q238413R3 <b>ISSUE DATE:</b> 09/08/11	<b>APP:</b> LK	<b>CITY, STATE, ZIP:</b> DUBLIN OH 43017	<b>PRINTER #:</b> 11-0186 <b>REVISION:</b> BL

3M VINYL		MAP PAINT		3M VINYL		MAP PAINT		3M VINYL		MAP PAINT	
Sapphire Blue (standard)	3032-9007	MP05519	White (standard)	3030-70***	Silver Gray (standard)	3030-121	MP05507	Silver Gray (standard)	180C-120	MP05507	
Sapphire Blue*** (standard)	180C-37	MP05510	White (standard)	180C-30	MP18336	Red (standard)	080-72	Red (standard)	080-72	MP18336	
Sky Blue*** (standard)	7725-87***		White (standard)	88C-10	MP18336	Yellow (standard)	080-71	Yellow (standard)	080-71	MP18336	
Vivid Green (standard)	3032-8043*	MP05508	White*** (standard)	OCG-10***		Black (standard)	180C-12	Black (standard)	180C-12	MP02201	
Apple Green*** (standard)	3032-108*	MP05502**	Clear*** (standard)	7735-154***		<b>ALL PAINT TO MATCH EXISTING</b>					
	USC-180***										

\* TO ACHIEVE OPALQUE FINISH FOR CUSTOM TRANSLUCENT VINYL COLORS - APPLY CUSTOM TRANSLUCENT VINYL OVER WHITE OPALQUE SUBSTRATE, 3M 1800-18 Wht, White Paint, STD.  
 \*\* TO BE APPLIED OVER 27486 27486 WHITE EPOXY PRIMER FOR MATTHEWS PAINT COMPANY TO ACHIEVE APPROVED VIVID GREEN COLOR.  
 \*\*\* TO BE USED FOR FABRICATION OF BANK LOGOS AND HARDWARE VINYL ONLY.  
 \*\*\*\* FOR SECOND SURFACE APPLICATION ONLY.

**APPROVED**  
 LINK E. HERRING, LLC  
 01-08-11

AFTER



BEFORE



35 SQ FT HORIZON/SHIELD - NON ILLUMINATED

SIGN W

HS35-NI


QTY - 1

FLOOR - N/A

ADDITIONAL FABRICATION & INSTALLATION NOTES

PATCH, PAINT, AND REPAIR WALL AS REQUIRED.


NEW SIGN TO BE RELOCATED TO WALL BEHIND TELLER LINE, CENTER ALONG WALL.

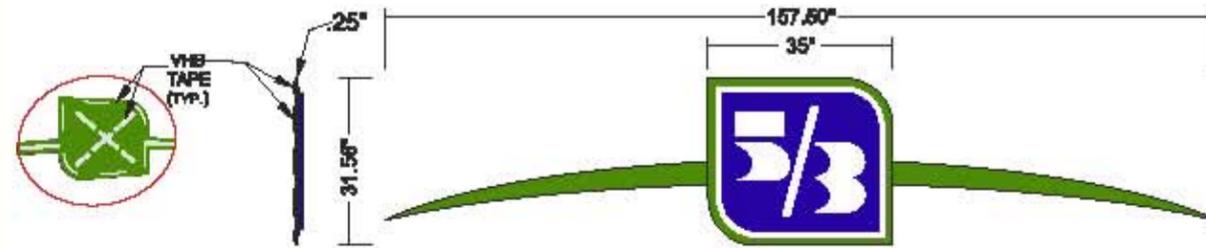

BACK OF SIGN ILLUSTRATING USE OF VHB TAPE INSTALLATION METHOD

ELEVATION

Area Calculations

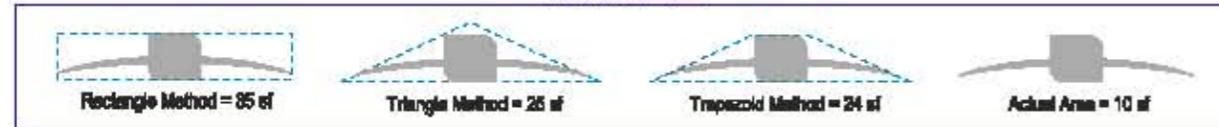

SIGN:

- Horizon/Shield Logo shapes to be .25" routed white acrylic.
- Horizon/Shield Logo shapes to be layered and chemically bonded as shown.
- All color shapes including edges to be painted as shown.

INSTALLATION:

- Mounted with VHB tape as required.

OVERALL BUILDING DIMENSIONS

H = N/A

L = N/A

EXISTING SIGN DIMENSIONS

H = 30"

L = 192"

OAH = N/A

SQ FT = 40

ADDITIONAL INFORMATION



		PROJECT SCOPE: EXISTING FACILITY RE-BRAND - OH100488 LOCATION: DUBLIN SHERMILL ADDRESS: 3899 WEST DUBLIN GRANVILLE ROAD CITY, STATE, ZIP: DUBLIN OH 43017 PHONE: 614-233-4133 FAX: 614-233-4133 WWW: FIFTHTHIRDBANK.COM		APPROVE: FTCO
PAGE: 26 OF 28 CURRENT REV: 3	SIGN # Q238413R3 DATE: 09/08/11 LK	PROJECT # 11-0158 ROOM # BL		

3M VINYL		MAP PAINT		3M VINYL		MAP PAINT		3M VINYL		MAP PAINT	
Sapphire Blue (standard)	3032-9007	MP06519	White (standard)	3030-70	Silver Gray (standard)	3030-121	MP06607				
Sapphire Blue (sheen)	180C-37	MP06510	White (standard)	3032-30	Silver Gray (sheen)	180C-120	MP06607				
Sapphire Blue*** (sheen)	7755-87		White (standard)	180C-10	Red (standard)	080-72					
Sky Blue (standard)	3032-8043*	MP06508	White (standard)	80C-10	Yellow (standard)	080-71					
Vivid Green (standard)	3032-108*	MP06502**	White*** (standard)	OCG-10***	Black (standard)	180C-12	MP02201				
Apple Green*** (sheen)	USC-180***		Clear*** (standard)	7735-154***							

\* TO ACHIEVE OPACQUE FINISH FOR CUSTOM TRANSLUCENT VINYL COLORS - APPLY CUSTOM TRANSLUCENT VINYL OVER WHITE OPACQUE SUBSTRATE, 3M 180C-10 She, White Paint, STD.  
 \*\* TO BE APPLIED OVER 274886-274888 WHITE EPOXY PRIMER FOR MATTERING PAINT COMPANY TO ACHIEVE APPROVED VIVID GREEN COLOR.  
 \*\*\* TO BE USED FOR FABRICATION OF BANK LOGOS AND HARDCAP VINYL ONLY.  
 \*\*\*\* FOR SECOND SURFACE APPLICATION ONLY.

APPROVED  
 LINK & HERRING, LLC  
 07-08-11



PROPERTY TYPE	Owned	CODE RESEARCH REPORT		CODES CONFIRMED			Yes
Location Name	Dublin Sawmill	Property ID/Affiliate	FTCO-OH100486	Parcel/Real Estate ID	273-009082-00		
Parcel/Lot Address	3800 W. Dublin-Granville	City	Dublin	State	OH	Zip	43017
Legal Description	BANKER DRIVE DUBLIN CITY CENTER PT RES 1=6.691 ACRES	Local Jurisdiction	Dublin	Zoning Classification	CC Community Commercial	Eng. Code	
		Local Jurisdiction Contact Information	Gary Gunderman Planning Manager (614)410-4682 ggunderman@dublin.oh.us, Rachael Beck (614)410-4663	Referenced Code(s) & Ordinance(s) & Information Resources	www.dublin-oh.us		

FREESTANDING SIGNS	
Are Freestanding Signs Allowed	Yes
Type of Primary Freestanding Sign Allowed	Ground (See Note about colors)
Number of Signs Allowed	1 per street front (See Notes)
Maximum Sq. Footage Allowed	50sqft for 1 sign, if 2 then total not to exceed 66.5sq ft
Maximum Overall Height	9ft
Minimum Setback	Avery Rd - 10ft.
Minimum Clearance Above Grade	NR
Site Distance Triangle Required	No
Calculation Formula	N/A
WALL SIGNS	
Are Wall Signs Allowed	Yes
Illumination Allowed	Yes (See Note about colors)
Number of Signs Allowed	2 (See Notes)
Maximum Sq. Footage Allowed	80sqft
Maximum Height Allowed	15ft
Maximum Projection Allowed	No
Calculation Formula	No
DIRECTIONAL SIGNS	
Are Directionals Allowed	Yes
Number of Signs Allowed	A/R
Maximum Sq. Footage Allowed	4 sq ft
Maximum Overall Height	3.5 ft
Minimum Setback	On Property
Do Directionals Count in Total Sq. ft allowed	No
Are Permits Required	No

TEMPORARY SIGNS	
Type of Temporary Signs Allowed (A-Frame, Portable, Banner, etc...)	Banner or Bag
Number of Signs Allowed	NR
Maximum Sq. Footage Allowed	NR
Maximum Overall Height	NR
Minimum Setback	Same as Permanent
Minimum Clearance Above Grade	NR
Duration of Sign Allowed	14 days
Are Permits Required	Yes
Additional restrictions	No
ATM SIGNS	
Are ATM Signs Allowed	Yes
Illumination Allowed	Yes - Background & only 3 colors
Number of Signs Allowed	NR
Maximum Sq. Footage Allowed	NR
Maximum Height Allowed	NR
Maximum Projection Allowed	NR
Are Permits Required	No
ADDITIONAL SIGN REGULATIONS	
Total Aggregate Sq. Footage Allowed	N/A
Total Aggregate Sq. Footage Based On (st. front, bldg. front, % of wall area, etc...)	N/A
Calculation Formula	N/A
Additional Site Setbacks (side, rear, etc...)	N/A
Additional Clearance Restrictions	N/A
Additional Restrictions	N/A

VINYL/WINDOW SIGNS	
Are Window/Vinyl Signs Allowed	Yes
Number of Signs Allowed	NR
Maximum Sq. Footage Allowed	2 sq ft total
Maximum Height Allowed	NR
Do Window/Vinyl Signs Count in Total Sq. ft Allowed	No
Are Permits Required	No
AWNING-CANOPY	
Are Awning-Canopy Signs Allowed	Yes
Number of Signs Allowed	NR
Maximum Sq. Footage Allowed	4 sq ft total
Maximum Height Allowed	Roof Line
Minimum Clearance Above Grade	Bottom of Canopy
Maximum Projection Allowed	NR
Do Awnings-Canopy Count in Total Sq. ft Allowed	No
Are Permits Required	No

PERMIT REQUIREMENTS	
Municipality Application	Yes
General Sign Site Plan	Yes
Sealed Site Survey	No
Building/Sign Elevations	Yes
Sealed Engineering Drawings	Yes - Link
Additional Documentation	See Notes
PERMIT PROCESS REQUIREMENTS	
Quantity of Permit Submittal Sets	14
Color or Black and White Copies	colors
Owner Signature Required	N/A
Cost of Permit	
Approximate Process Time	1 month to get it to the Planning
Does process include (Historic, Architectural, or other) Approval	Planning & Public review
Electrical Permit Required	Yes - if new service or if moved
Building Permit Required	No
Inspections Required (electrical, foundation, etc...)	Yes

**TOP** | **CODE RESEARCH NOTES** | **HOME**

Signs Allowed: One location can choose either (2) Wall signs, or (2) Freestanding signs, a combination is NOT allowed.  
 Graphics regulations: Sign must only have three colors. Graphics must not exceed 20% of the sign face. White is considered a color when choosing the three colors for the sign.

Permit documentation required: One (1) original signed application, One (1) scaled & dimensioned site plan, One (1) scaled & dimensioned sign elevation, One (1) scaled & dimensioned landscape plan for new ground signs, listing the type, size, & quantity of all parts (Not required for face replacements)  
 Public Review Meeting: One person of authority to come to the meeting.



8081 EXECUTIVE PARK DR.  
 SUITE 2000  
 CINCINNATI, OH 45240  
 PHONE 513-963-4001  
 FAX 513-963-0881  
 WWW.FIFTHTHIRDBANK.COM

Project: 11-0166  
 Issue Date: 09/06/11  
 Date: 09/06/11  
 LK

PROJECT SCOPE: EXISTING FACILITY RE-BRAND - OH100486  
 LOCATION: DUBLIN SAWMILL  
 ADDRESS: 3800 WEST DUBLIN GRANVILLE ROAD  
 CITY, STATE, ZIP: DUBLIN OH 43017  
 PROJECT #: 11-0166  
 DRAWN BY: BL  
 REV: 001  
 DATE: 09/06/11

BY	DATE	REVISION / APPROVAL TYPE	STATUS
08/01/11		Approved per client	SG
08/28/11		Release Signs G-1, Release Sign YL	SG
09/06/11		Release Signs A, B, C, D and Sign K - 0 per clients request.	BL

REVISION / APPROVAL TYPE	STATUS	BY
CLIENT FINAL APPROVAL	<input type="checkbox"/> Pending <input type="checkbox"/> Approved	FILED THIS BANK - JJ
LOCAL JURISDICTION PRELIMINARY REVIEW	<input type="checkbox"/> Pending <input type="checkbox"/> Approved	
CITY/STATE PRELIMINARY APPROVAL	<input type="checkbox"/> Pending <input type="checkbox"/> Approved	
CITY PRELIMINARY APPROVAL	<input type="checkbox"/> Pending <input type="checkbox"/> Approved	FILED THIS BANK - JJ

**APPROVED**  
 LINK & HERRING INC., LLC  
 DP-08-11