

DAVIDSON PHILLIPS INC.

1152 GOODALE BLVD.
COLUMBUS, OHIO 43212


PHONE: 614-297-0404 FAX: 614-297-0383

TYPE OF HOUSE 505 'C' P.B. 85 PG. 26

CITY OF DUBLIN LOT NO. 143

SCALE 1"=20' SUBMISION HAWKS NEST SEC 2 PHD

DATE 2/24/00 ADDRESS 7740 FULMAR DRIVE

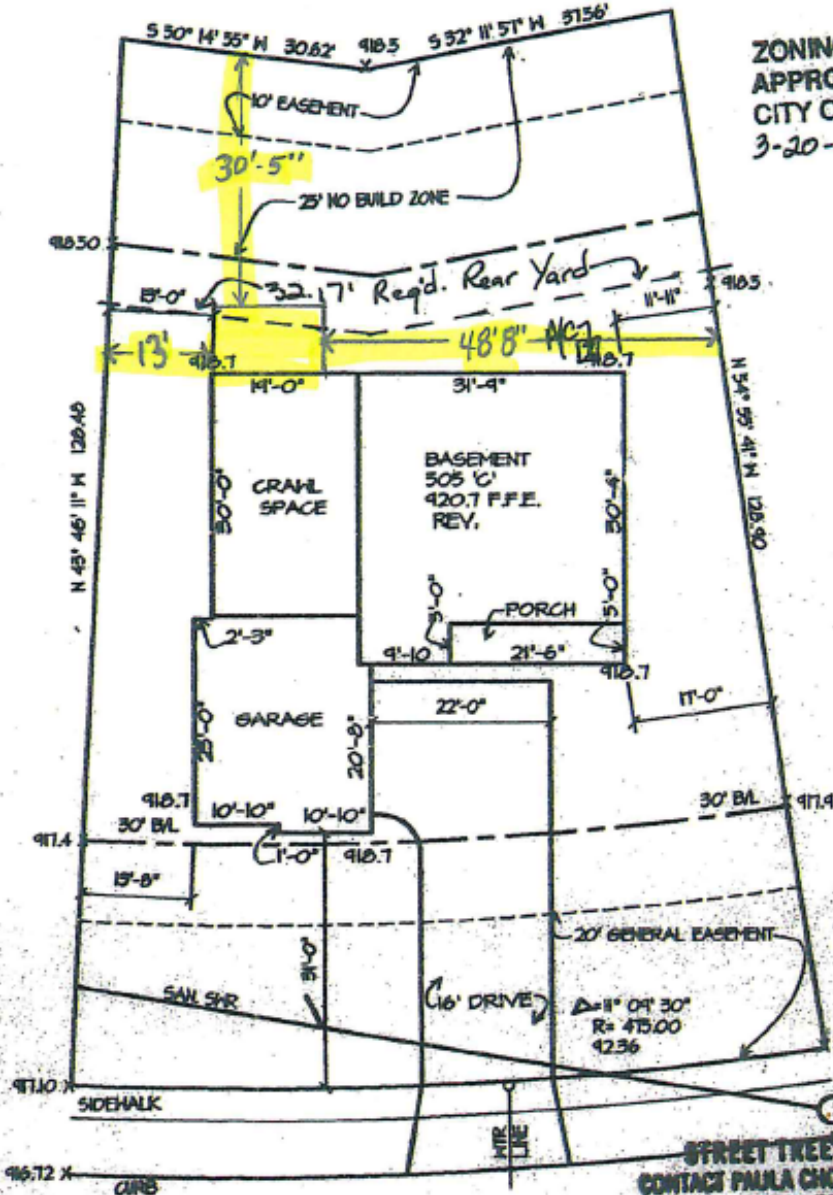

ZONING COMPLIANCE
APPROVED AS NOTED
CITY OF DUBLIN, OHIO
3-20-00 VC

SIDEWALKS REQUIRED
CONTACT ENGINEERING DIV.
761-6550

STREET TREES REQUIRED
CONTACT PAULA CHOPE, CITY FORESTER
614 761-8327
CALL PRIOR TO INSTALLATION
FOR TREE PLACEMENT

FULMAR DRIVE 50' R/W