

6505 DUBLIN CENTER DR - DUBLIN, OH 43017

PROJECT DIR	IRECTORY					
TENANT	LANDLORD	ARCHITECT OF RECORD	PLANNING & ZONING AUTHORITY			
FIRST WATCH RESTAURANTS INC. 8725 PENDERY PLACE., SUITE 201 BRADENTON, FL 34201 PHONE: (941) 907-9800	PARADIGM DEVELOPMENT GROUP 3974 BROWN PARK DR. SUITE E HILLIARD, OH 43026 CONTACT: BRETT LESLIE EMAIL: brett.paradigmdg@gmail.com	ARCHITECTURAL GROUP INTERNATIONAL 15 WEST SEVENTH STREET COVINGTON, KENTUCKY 41011 CONTACT: MEGAN ESSWEIN PHONE: (859) 261-5400 FAX: (859) 261-5530 EMAIL: messwein@agi-us.com	CITY OF DUBLIN PLANNING DEPARTMENT 5200 EMERALD PARKWAY DUBLIN, OH 43016 CONTACT: TAYLOR MULLINAX PHONE: (614) 410-4600 EMAIL: tmullinax@dublin.oh.us			

	CODE	INFORM <i>A</i>	ATION	
GENERAL BUILDING CODE DA	ATA	CHAPTER 8 - INIT	FERIOR FINISHES	
PROJECT DESCRIPTION: APPLICABLE CODES: BUILDING: STRUCTURAL: PLUMBING: MECHANICAL: ELECTRICAL: FIRE/LIFE SAFETY:	2017 OHIO BUILDING CODE 2017 OHIO BUILDING CODE 2017 OHIO BUILDING CODE 2017 OHIO BUILDING CODE 2017 OHIO PLUMBING CODE 2017 OHIO PLUMBING CODE 2017 OHIO MECHANICAL CODE 2017 OHIO MECHANICAL CODE 2017 OHIO FIRE CODE	TABLE 803.5 USE A-2 A: INTERIO		CLASS B CLASS C CLASS II AND DOC FF-1 "PILL TEST" OR HIGHER CLASS II AND DOC FF-1 "PILL TEST" OR HIGHER
ACCESSIBILITY: ENERGY CODE: GAS PIPING:	CURRENT ADA STANDARDS FOR ACCESSIBLE DESIGN OHIO ENERGY CODE, CHAPTER 13, 2012 INTERNATIONAL ENERGY CODE 2015 INTERNATIONAL FUEL GAS CODE	CHAPTER 9 - FIF 903.2.1.2	RE PROTECTION SYSTEMS AUTOMATIC SPRINKLER SYSTEM NOT REQUIRED B.	ASED ON THE TENANT OCCUPANT LOAD AND SQUARE FOOTAGE.
CHAPTER 3 - USE AND OCCU 303 CHAPTER 6 - TYPE OF CONST CLASSIFICATION: FIRE-RESISTANCE RATINGS (A-2 - ASSEMBLY (RESTAURANT) TRUCTION VB (TABLE 601):			19 OCCUPANTS 5 NET SF PER OCCUPANT 52 OCCUPANTS 24" OF SEATING PER OCCUPAN 77'-11" LINEAR FT.) 52 OCCUPANTS 18" OF SEATING PER OCCUPAN 261 SF = 1091 SF) 72 OCCUPANTS 15 NET SF PER OCCUPANT 42 OCCUPANTS 11 OCCUPANTS 200 GROSS SF PER OCCUPAN
STRUCTURAL FRAME: BEARING WALLS: INTERIOR:	0 HOURS 0 HOURS	TOTAL:		EGRESS CALCULATION PLUMBING FIXTURE CALCULATION
EXTERIOR: NON-BEARING WALLS: INTERIOR: EXTERIOR:	0 HOURS 0 HOURS 0 HOURS		MAXIMUM EXIT ACCESS TRAVEL DISTANCE FOR AS MINIMUM NUMBER OF REQUIRED EXITS = 2 (LESS T	
FLOOR CONSTRUCTION: ROOF CONSTRUCTION:	0 HOURS 0 HOURS	CHAPTER 11 - A PROJECT HA	CCESSIBILITY S BEEN DESIGNED TO BE ACCESSIBLE IN ACCORDANG	CE WITH ANSI A117.1 GUIDELINES.

GENE	RAL NOTES		<u></u>	2
ARCHITECURAL		ORIGNIAL DRAWING DATE	REVISION 04/12/2022	REVISION 06/02/2022
A001A	COVER SHEET	04/07/2022	X	X
A003	OVERALL BUILDING PLAN	04/07/2022		X
A004	SITE PLAN	04/12/2022		Х
A101	FLOOR PLAN	04/12/2022		Х
A102	FURNITURE & FIXTURE PLAN	04/12/2022		Х
A107	PATIO PLAN & DETAILS	04/12/2022		Х
A501	EXTERIOR ELEVATIONS	04/07/2022	X	X
A502	EXTERIOR ELEVATIONS	04/07/2022		X
E111	ELECTRICAL PHOTOMETRICS	05/25/2022	 Y · Y · Y · Y	X

PROJECT SCOPE


THE WORK WILL CONSIST OF NEW CONCRETE WALK WAY AT NEW DOOR, NEW WINDOWS AT PREVIOUSLY INFILLED SPACES, & NEW EXTERIOR FINISHES

THE EXISTING SPACE'S CURRENT USE IS (A-2) ASSEMBLY. WE WILL BE KEEPING THE SAME USE.


FUTURE SCOPE ON INTERIOR WORK TO BE ISSUED UNDER SEPARATE CONSTRUCTION DRAWINGS.

VICINITY MAP

FIRST WATCH

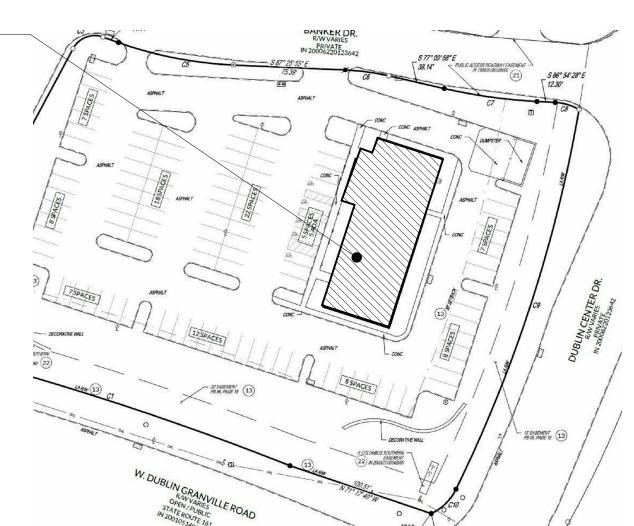

KEY PLAN

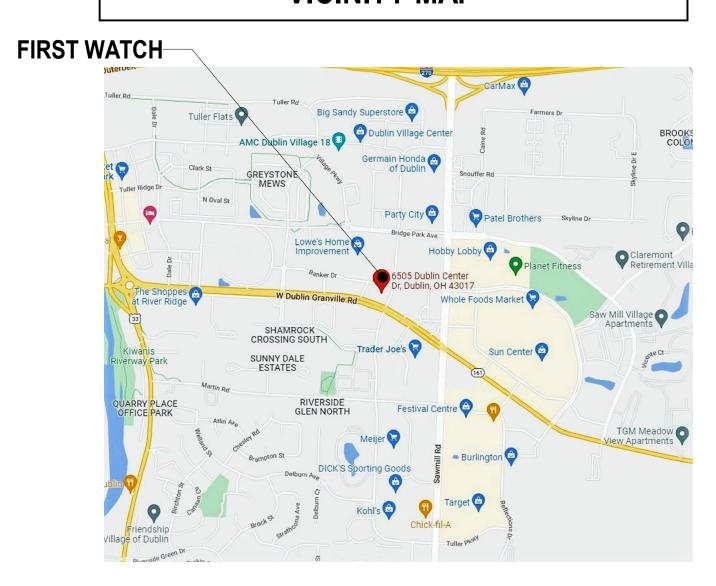

THE THE

P: 859.261.5400 F: 859.261.5530 www.agi-us.com designing where you want to **go**.

This drawing is the property of ARCHITECTURAL GROUP INT'L and is not to be reproduced or copied in whole or in part. It is only to be used for the project and site specifically identified herein and is not to be used on any other project. It is to be returned upon request. Scales as stated herein are valid on the original drawing only. Contractor shall carefully review all dimensions and conditions shown herein and at once report to the Architect any error, inconsistency or omission he may

04/07/2022 MN

04/25/2022 MN

04/12/2022 MN CITY

06/02/2022 MBE OWNER

PLANNING APPROVAL


FIRST WATCH SAWMILL


DUBLIN, OH


PROJECT # 22
DATE ISSUED 4/

COVER SHEET

A001A

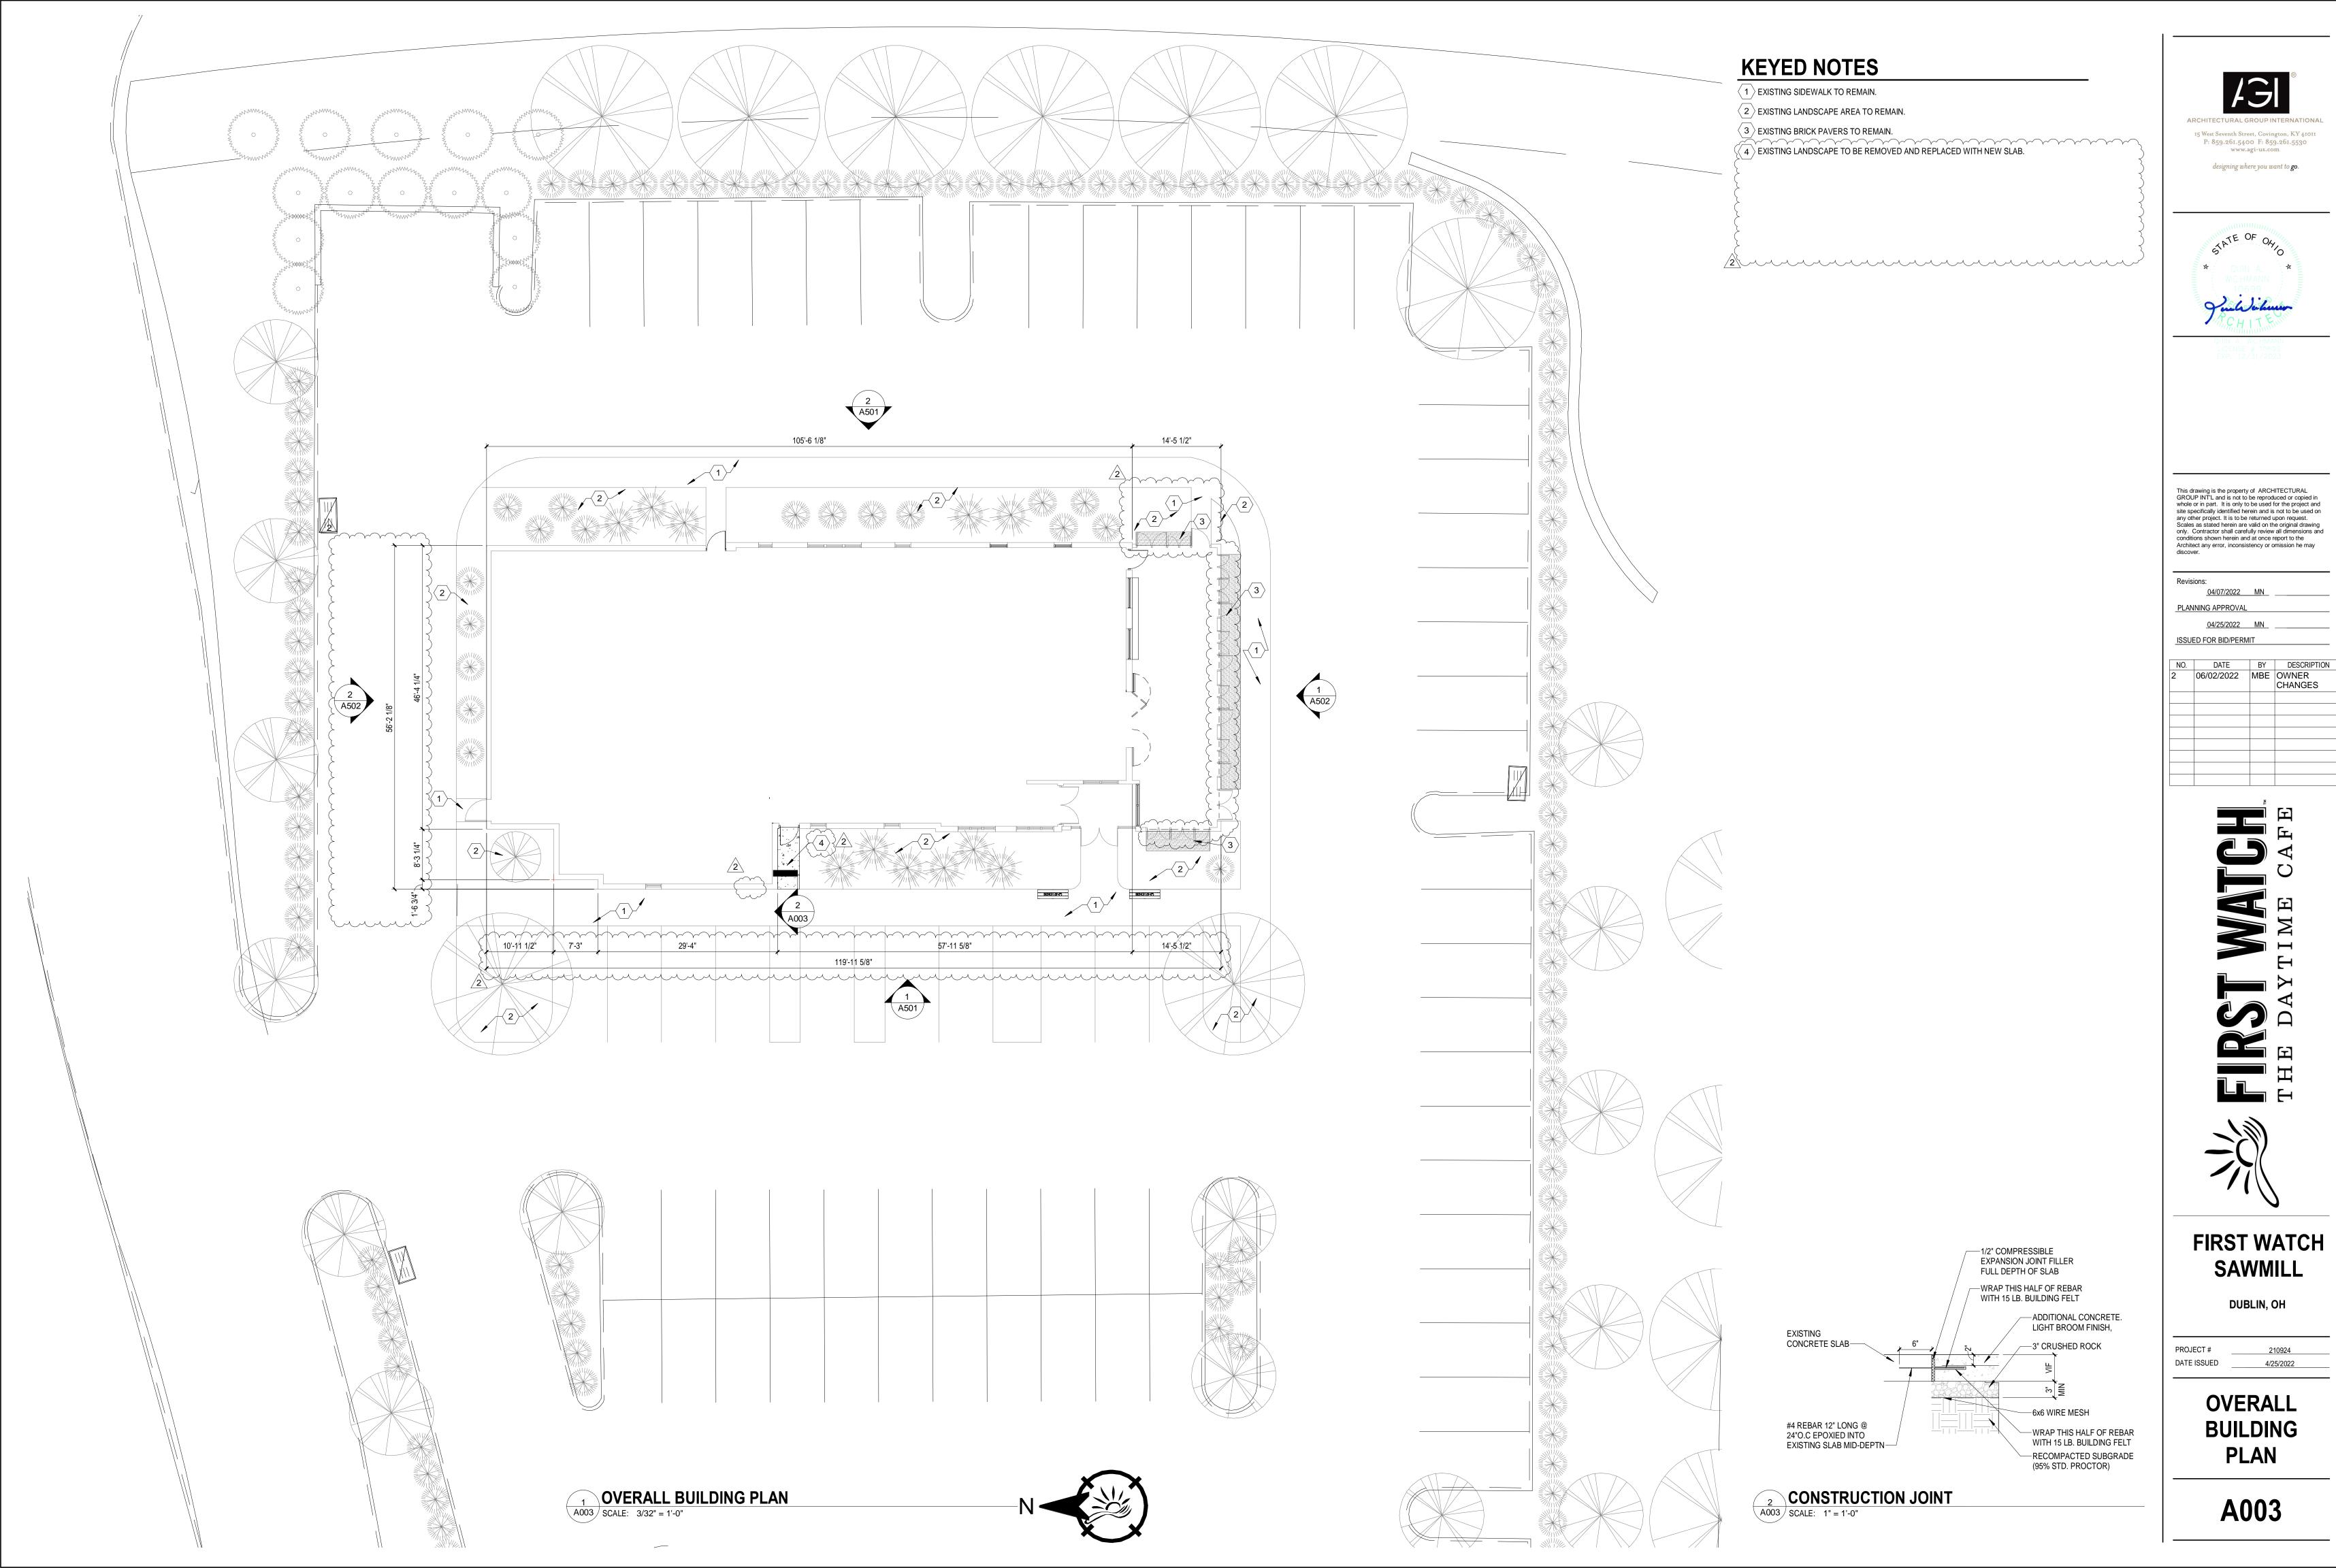

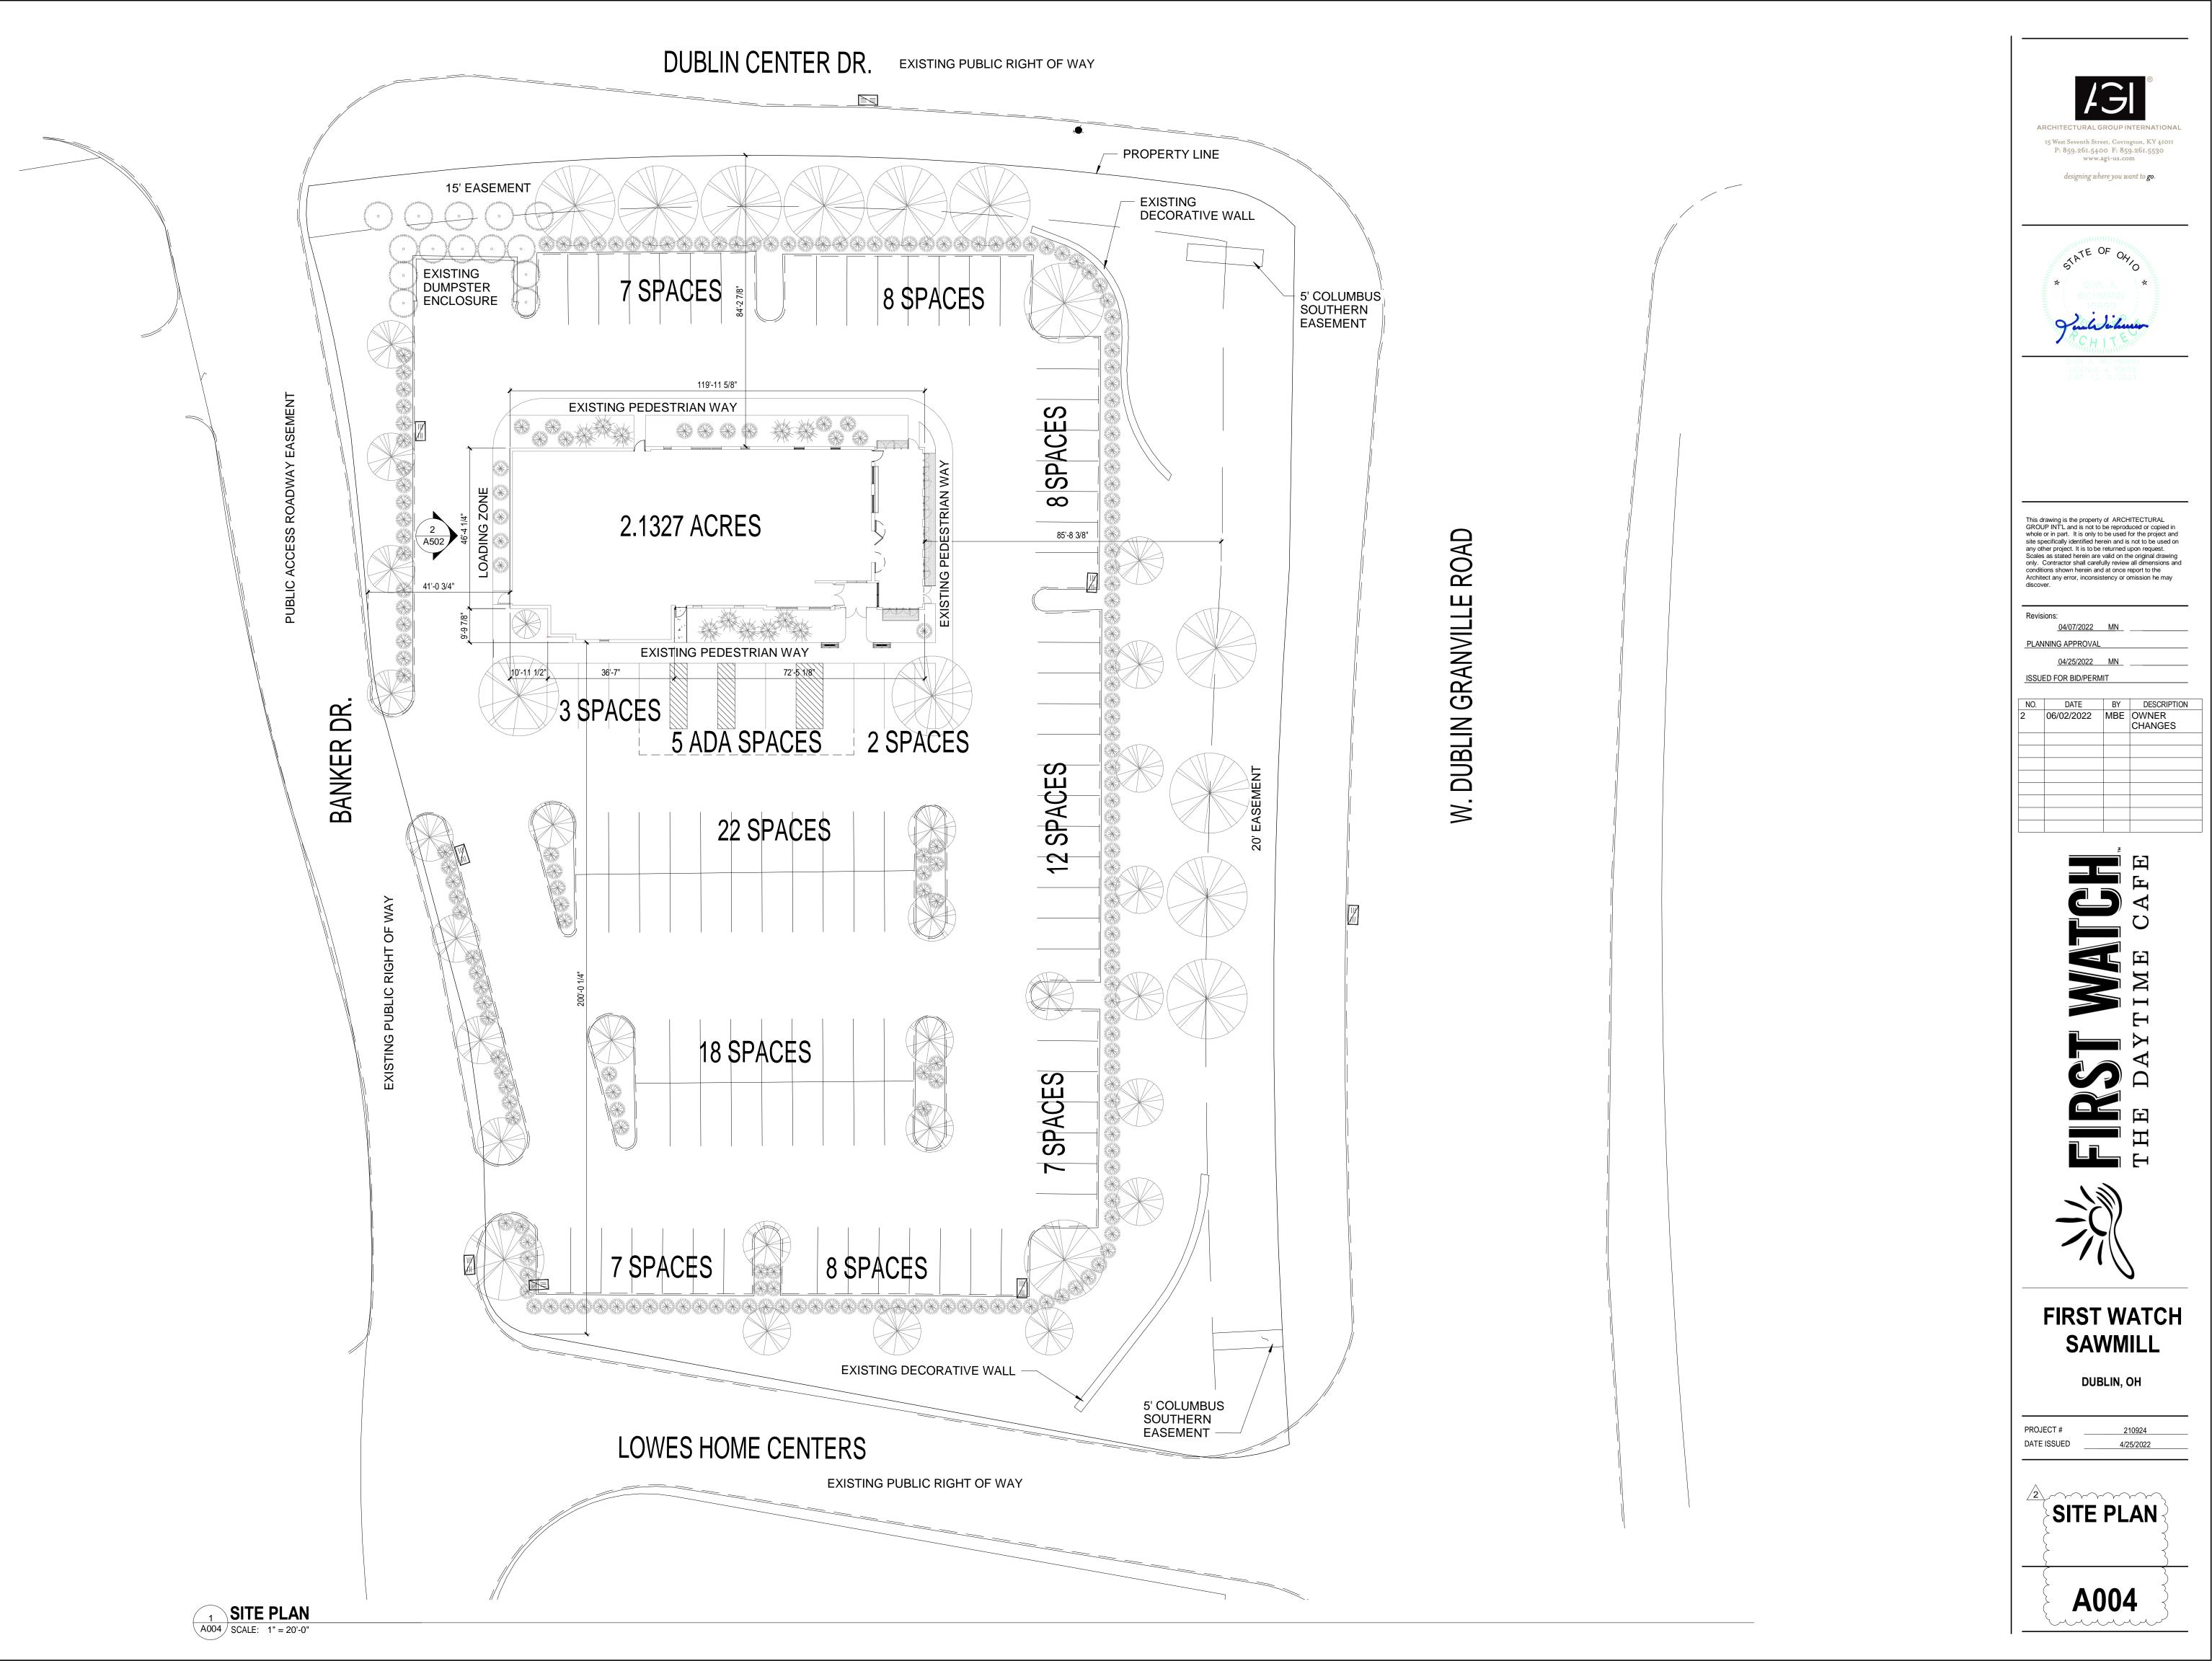

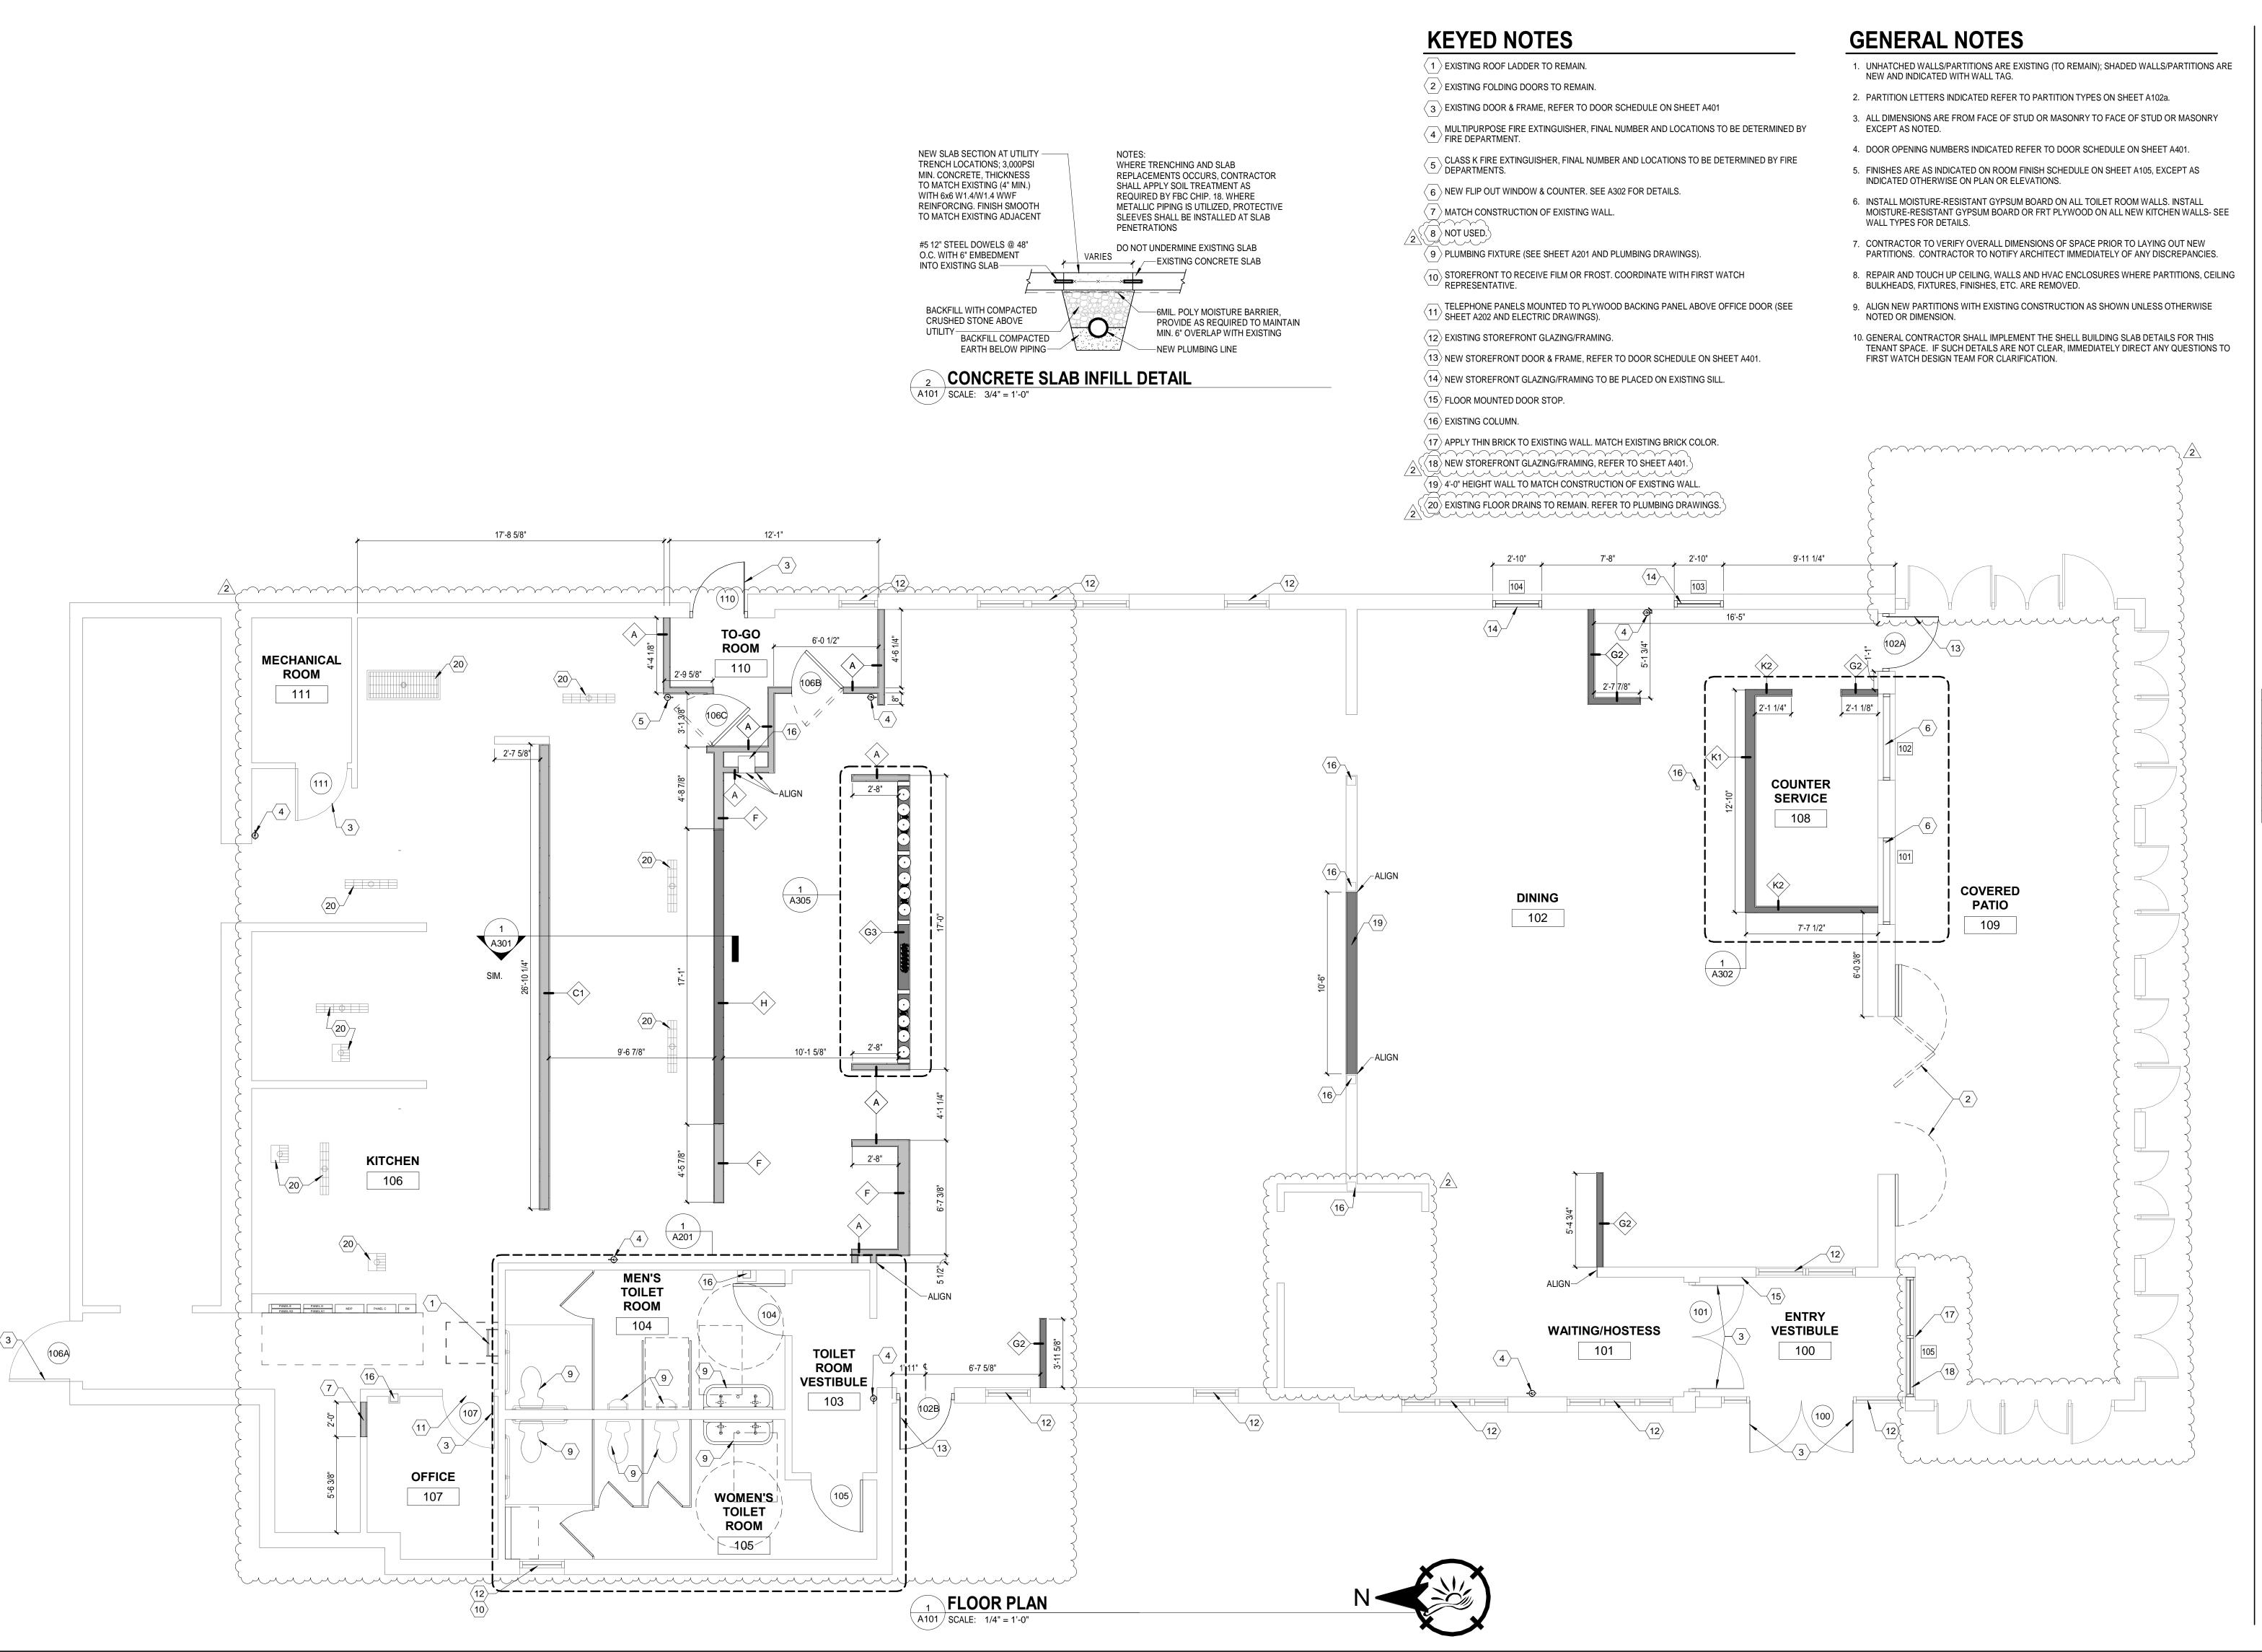



P: 859.261.5400 F: 859.261.5530

www.agi-us.com

designing where you want to go.

This drawing is the property of ARCHITECTURAL GROUP INT'L and is not to be reproduced or copied in whole or in part. It is only to be used for the project and site specifically identified herein and is not to be used on any other project. It is to be returned upon request. Scales as stated herein are valid on the original drawing only. Contractor shall carefully review all dimensions and conditions shown herein and at once report to the Architect any error, inconsistency or omission he may discover.

NO. DATE BY DESCRIPTION

O6/02/2022 MBE OWNER
CHANGES

HE DAYTIME CAF




FIRST WATCH SAWMILL

DUBLIN, OH

PROJECT # 210924

DATE ISSUED 4/25/2022

FLOOR PLAN

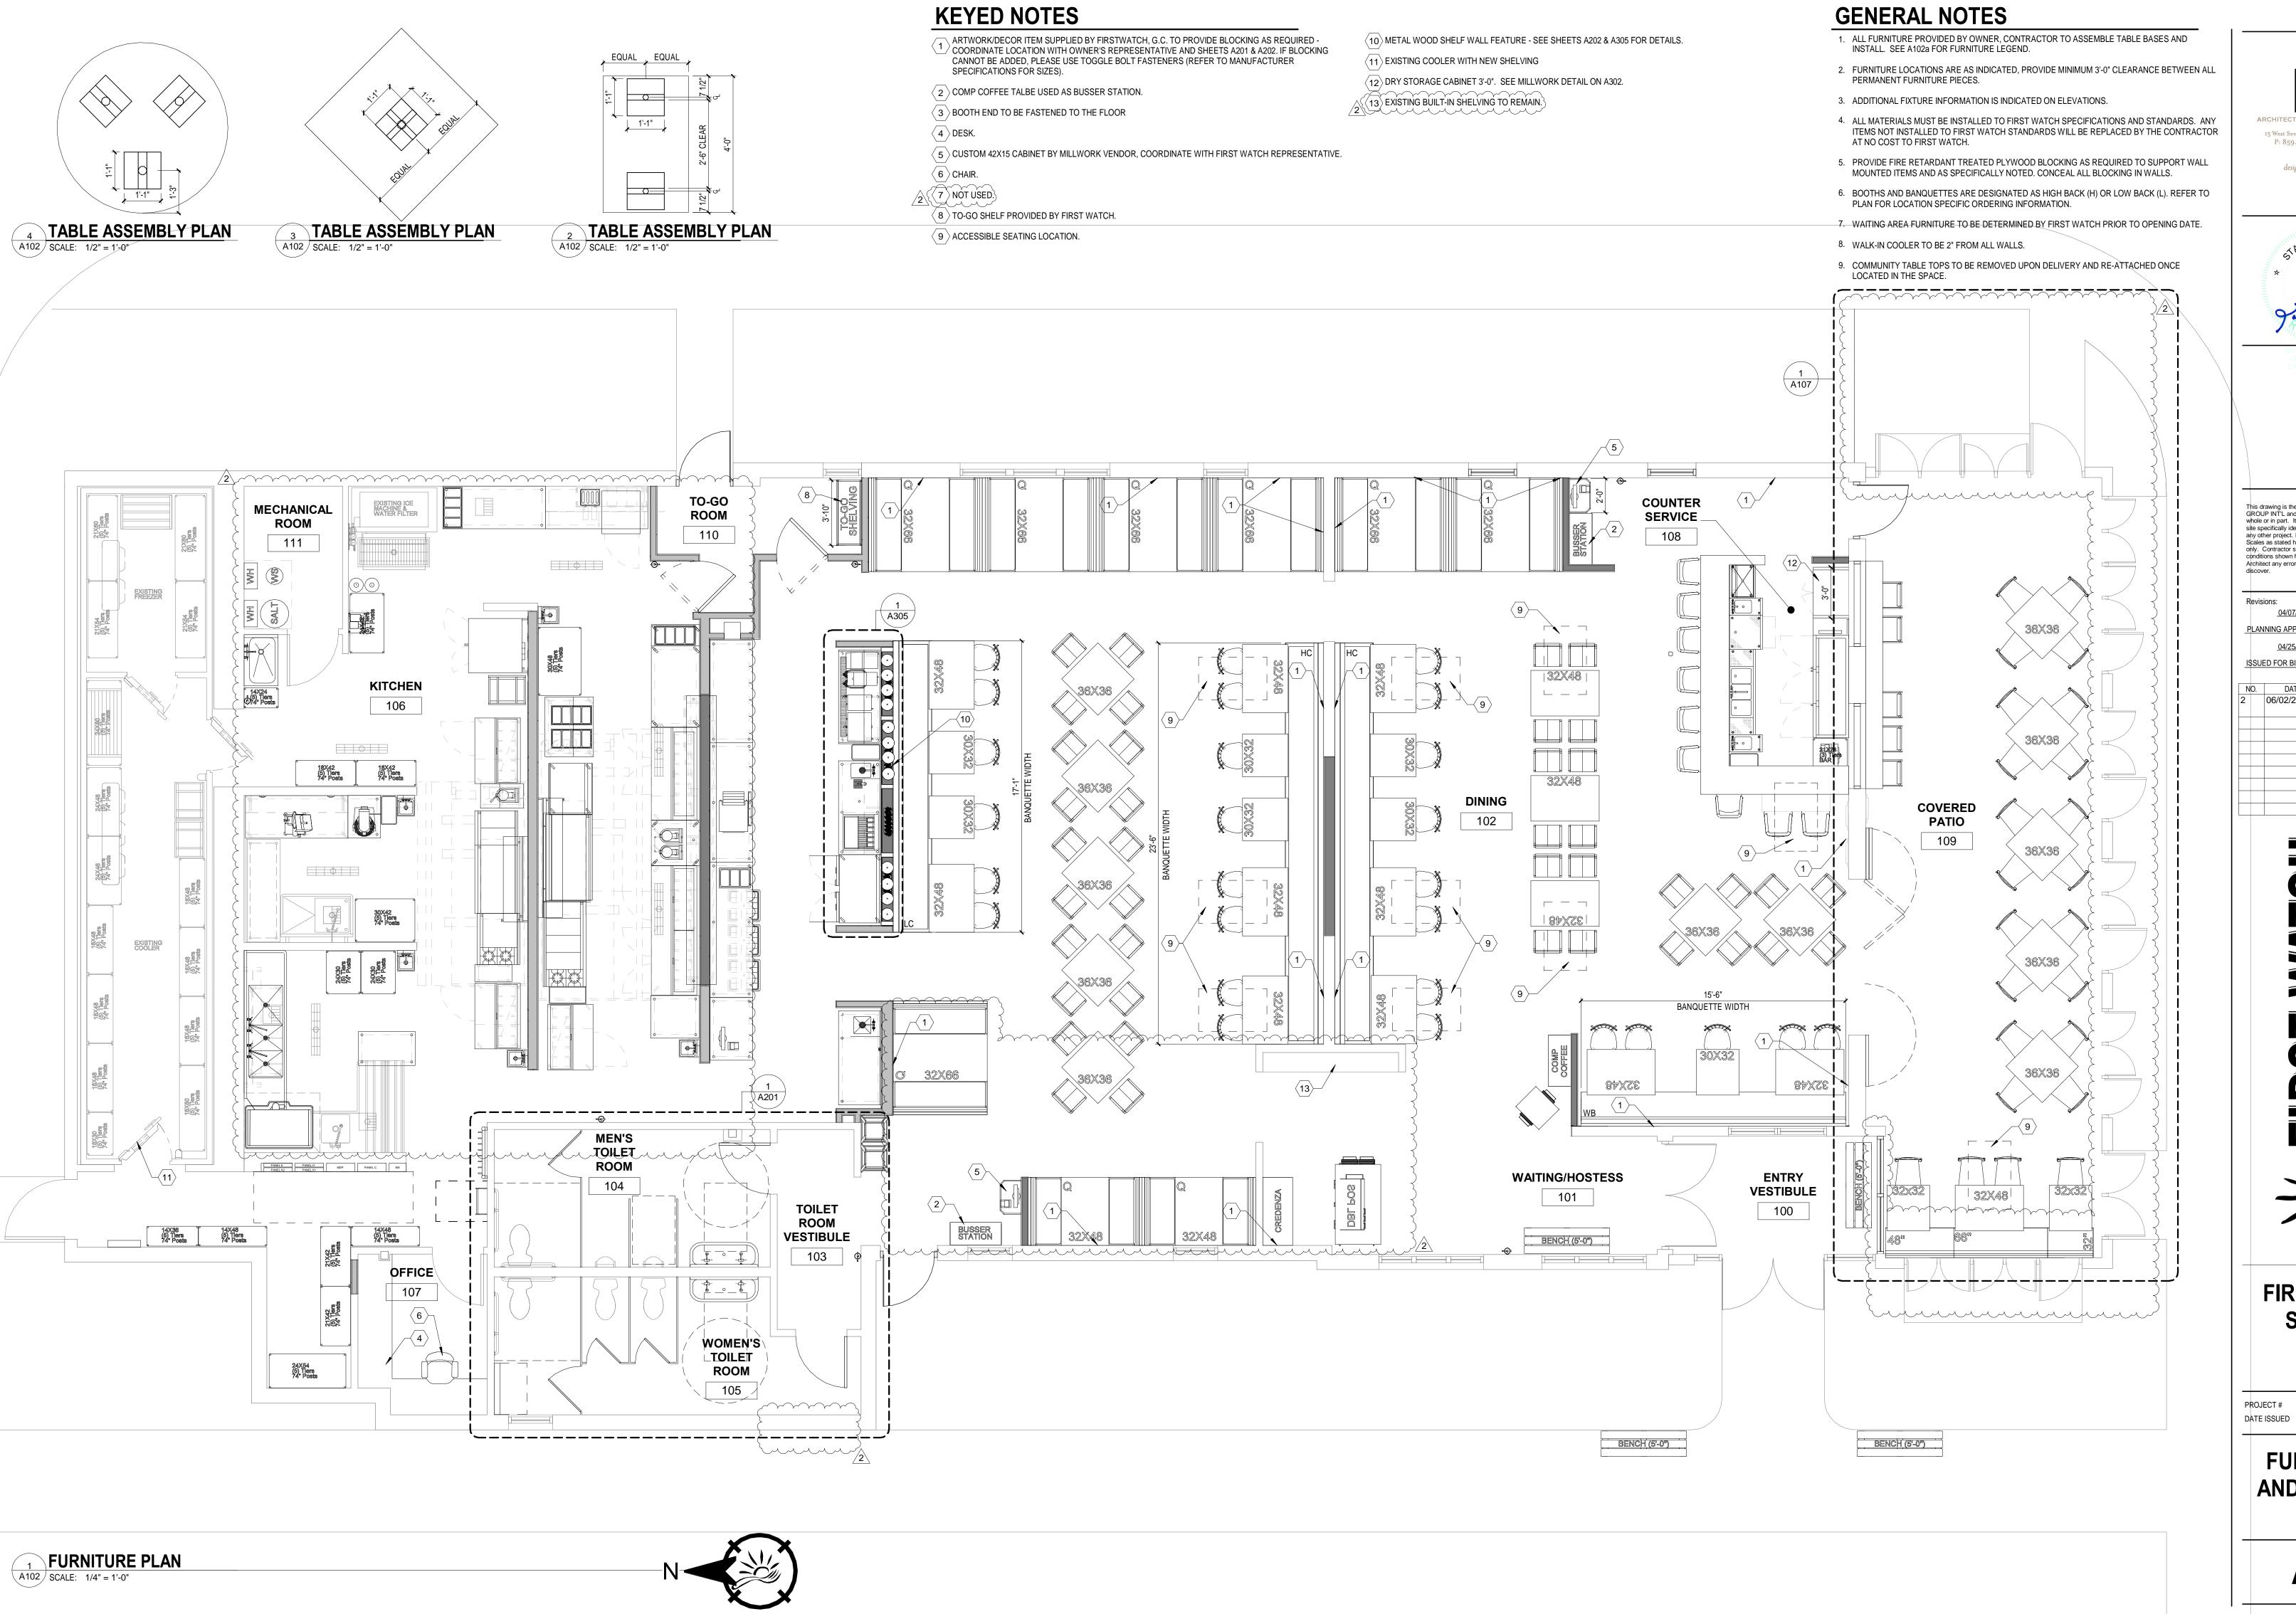

RCHITECTURAL GROUP INTERNATIO

P: 859.261.5400 F: 859.261.5530 www.agi-us.com designing where you want to **go**.



This drawing is the property of ARCHITECTURAL GROUP INT'L and is not to be reproduced or copied in whole or in part. It is only to be used for the project and site specifically identified herein and is not to be used on any other project. It is to be returned upon request. Scales as stated herein are valid on the original drawing only. Contractor shall carefully review all dimensions and conditions shown herein and at once report to the Architect any error, inconsistency or omission he may discover.

Revisions:

04/07/2022 MN

PLANNING APPROVAL

04/25/2022 MN

04/25/2022 MN

ISSUED FOR BID/PERMIT

DATE BY DESCRIPTION

06/02/2022 MBE OWNER CHANGES

ST WE CAFE



FIRST WATCH SAWMILL


DUBLIN, OH

SSUED _____4

FURNITURE AND FIXTURE PLAN

~~~~	$\sim\sim\sim$	~~~~~~~~~~~~~~~~~~~~~~~~~~~~~~~~~~~~~~		\	$\sim\sim\sim$	~~~~~	~~~~~~~~~~~~~~~~~~~~~~~~~~~~~~~~~~~~~~	
FACAI	DE PE	RCENT CH	HANGE		FACAI	DE TR	ANSPARE	NCY PERCENTAGES
ELEVATION	TOTAL SF	PERCENT CHANGED	NOTES		ELEVATION	GLAZED SF	TRANSPARENCY %	NOTES
NORTH	1,147	33% (375 SF CHANGED)	SOME BRICK PAINTED, SERVICE DOOR & DOWNSPOUTS PAINTED		NORTH	0	0%	SAME AS EXISTING. NO PROPOSED MODIFICATIONS.
SOUTH	1,288	52% (673 SF CHANGED)	SOME BRICK PAINTED, NEW SLOPED ROOF, CURVED PARAPET REMOVED, INTERIOR PORTION OF BRICK WALL TO RECEIVE MURAL.		SOUTH	125	37%	SAME AS EXISTING. NO PROPOSED MODIFICATIONS.
EAST	2,405	50% (1,201 SF CHANGED)	SOME BRICK PAINTED, NEW SLOPED ROOF, TWO WINDOWS ADDED, TRIM AROUND WINDOWS & DOORS PAINTED.		EAST	114	16%	TWO WINDOWS ADDED ON PREVIOUS BLANK AREAS.
WEST	2,416	45% (1,079 SF CHANGED)	SOME BRICK PAINTED, NEW SLOPED ROOF, TRIM AROUND WINDOWS & DOORS PAINTED.		WEST	156	22%	SAME AS EXISTING. NO PROPOSED MODIFICATIONS TO TRANSPARENCY.

FACADE PERCENT CHANGE		FACA	DE TRA	ANSPARE	NCY PERCENTAGES		
ELEVATION	TOTAL SF	PERCENT CHANGED	NOTES	ELEVATION	GLAZED SF	TRANSPARENCY %	NOTES
NORTH	1,147	33% (375 SF CHANGED)	SOME BRICK PAINTED, SERVICE DOOR & DOWNSPOUTS PAINTED	NORTH	0	0%	SAME AS EXISTING. NO PROPOSED MODIFICATIONS.
SOUTH	1,288	52% (673 SF CHANGED)	SOME BRICK PAINTED, NEW SLOPED ROOF, CURVED PARAPET REMOVED, INTERIOR PORTION OF BRICK WALL TO RECEIVE MURAL.	SOUTH	125	37%	SAME AS EXISTING. NO PROPOSED MODIFICATIONS.
EAST	2,405	50% (1,201 SF CHANGED)	SOME BRICK PAINTED, NEW SLOPED ROOF, TWO WINDOWS ADDED, TRIM AROUND WINDOWS & DOORS PAINTED.	EAST	114	16%	TWO WINDOWS ADDED ON PREVIOUS BLANK AREAS.
WEST	2,416	45% (1,079 SF CHANGED)	SOME BRICK PAINTED, NEW SLOPED ROOF, TRIM AROUND WINDOWS & DOORS PAINTED.	WEST	156	22%	SAME AS EXISTING. NO PROPOSED MODIFICATIONS TO TRANSPARENCY.

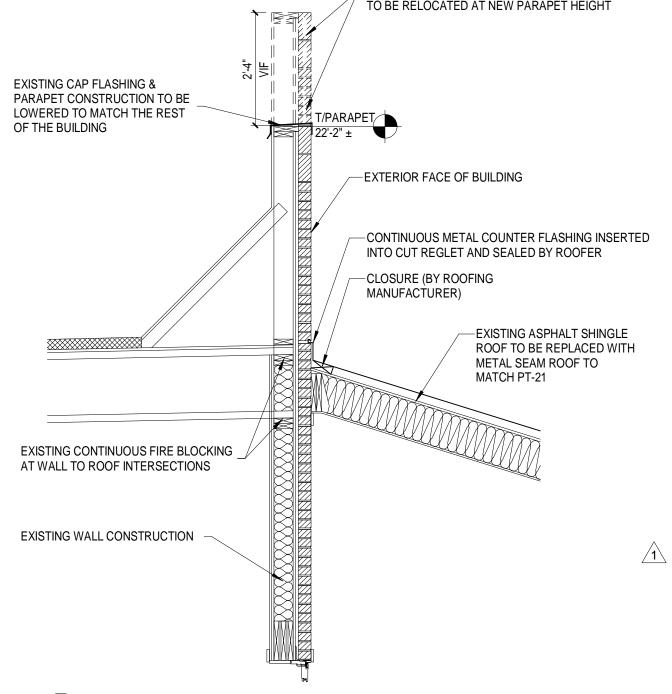

# **GENERAL NOTES**

1. ALL MATERIALS MUST BE INSTALLED TO FIRST WATCH SPECIFICATIONS AND STANDARDS. ANY ITEMS NOT INSTALLED TO FIRST WATCH STANDARDS WILL BE REPLACED BY THE CONTRACTOR AT NO COST TO FIRST WATCH.

2. G.C. TO PAINT ALL EXTERIOR STOREFRONT FRAMING PT-21.

#### **KEYED NOTES**

(1) EXISTING ROOF TO BE REPLACED WITH METAL SEAM ROOF- BERRIDGE TEE-PANEL IN MATTE

 $\langle$   $_{2}$   $\rangle$  EXISTING PATIO DOOR/WINDOW FRAMES AND STILES TO BE PAINTED PT-21. (3) SIGNAGE BY SIGN VENDOR. SIGNAGE UNDER SEPARATE PERMIT.

4 NEW TROY SLOPE SCONCES TO REPLACE EXISTING SCONCES.

2 5 NOT USED.

 $\langle$  6  $\rangle$ NEW WINDOWS IN PREVIOUS OPENINGS.

COLOR

SW 7069 IRON ORE

FORGED IRON

ANTIQUE WOOD BARNWOOD PANEL

EXTERIOR PAINT SW 7636 ORIGAMI WHITE

EXTERIOR PAINT

REALSTONE

DESCRIPTION

26" TROY SLOPE

EXTERIOR LIGHT

SCONCE

SYSTEMS

WP-14

(7) PAINT ALL WINDOW & DOOR FRAMES AND DOWNSPOUTS PT-21 OR REPLACE TO MATCH PT-21. COORDINATE WITH FIRST WATCH REPRESENTATIVE.

NOTES

WITH FIRST WATCH REPRESENTATIVE

 $\langle \mathsf{8} \rangle$  NEW AWNING TO MATCH NEW ROOF. PROVIDED BY SIGNAGE VENDOR.  1 

<b>\</b>		
(	CATIONS	
	NOTES	
•		
	INSTALL PER MANUFACTURER'S INSTRUCTIONS. USE CORNER SCHLUTER IN SATIN NICKEL ANODIZED	

ALUMI. INSTEAD OF CORNER PANELS. COORDINATE This drawing is the property of ARCHITECTURAL GROUP INT'L and is not to be reproduced or copied in whole or in part. It is only to be used for the project and site specifically identified herein and is not to be used on any other project. It is to be returned upon request.

> conditions shown herein and at once report to the Architect any error, inconsistency or omission he may Revisions: 04/07/2022 MN PLANNING APPROVAL

> Scales as stated herein are valid on the original drawing only. Contractor shall carefully review all dimensions and

P: 859.261.5400 F: 859.261.5530

www.agi-us.com

designing where you want to go.

04/25/2022 MN ISSUED FOR BID/PERMIT 04/12/2022 MN CITY

NO. DATE DESCRIPTION COMMENTS 2 06/02/2022 MBE OWNER CHANGES





## **FIRST WATCH SAWMILL**


DUBLIN, OH

DATE ISSUED

**EXTERIOR ELEVATIONS** 

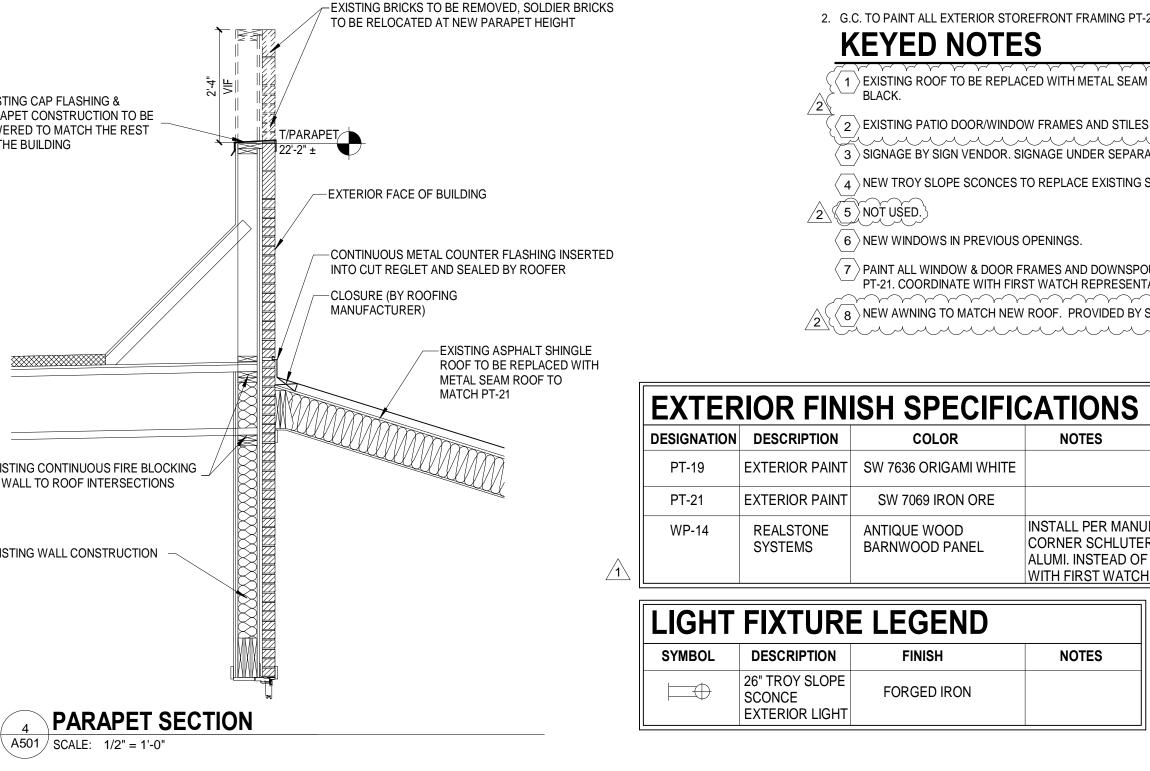

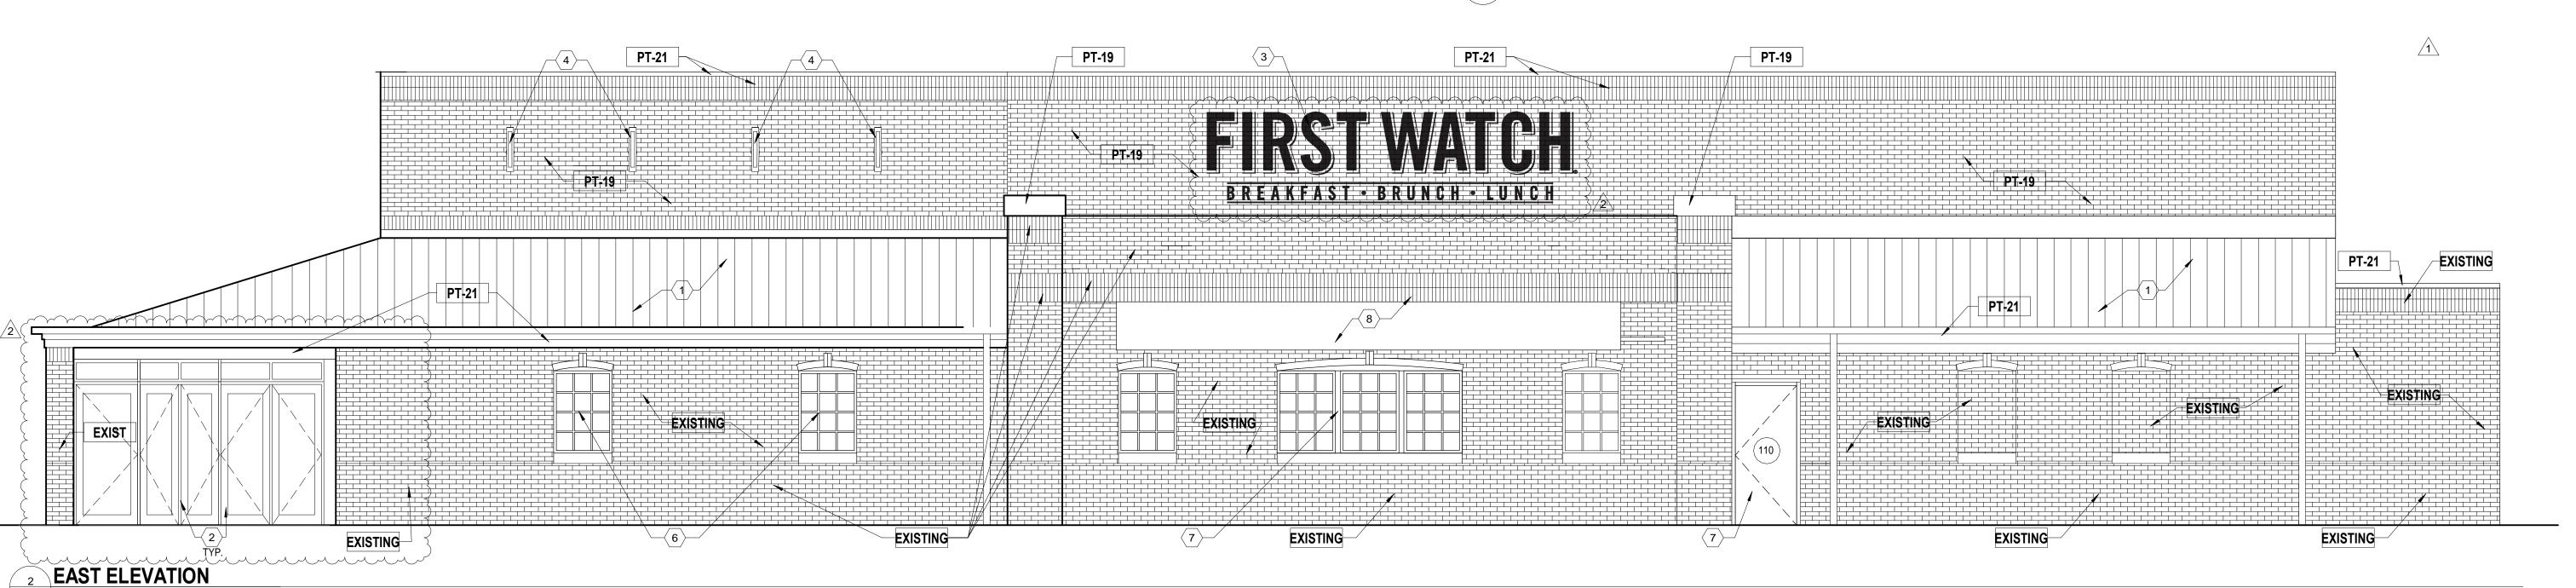

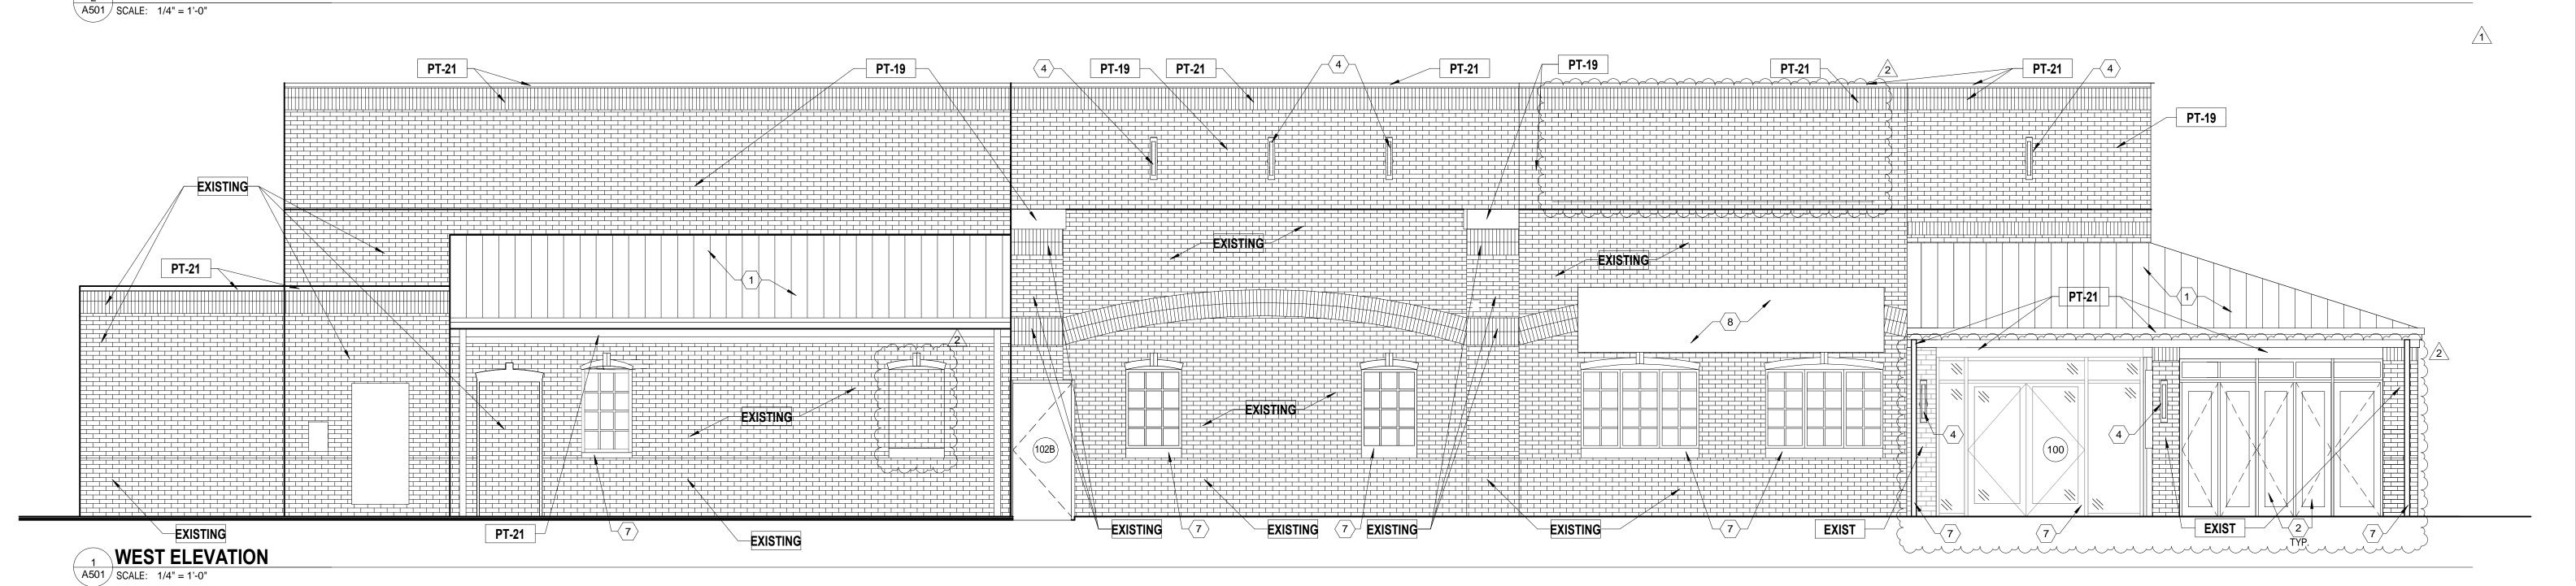

# **CONSTRUCTION CONTACT DIRECTORY** -

ALTERNATE VENDORS MAY BE USED PENDING FIRST WATCH APPROVAL

ITEM SUPPLIED	CONTRACTOR/ SUPPLIER
EXTERIOR RAILING POST	STAINLESS CABLE & RAILING INC. CABLE - VIEW ALUMINUM RAILING OR EQUAL. POST TO BE POWDER COATED FLAT BLACK FINISH

## **GENERAL NOTES**


1. ALUMINUM/STEEL POST AND WOOD PROVIDED BY G.C.

2. G.C. TO CONFIRM WITH FIRST WATCH REPRESENTATIVE IF POST SHOULD BE CONSTRUCTED WITH ALUMINUM OR STEEL.

## **KEYED NOTES**


- $\langle$  1  $\rangle$  NOT USED. 2 EXISTING SIDEWALK
- (3) EXISTING LANDSCAPING
- $\{\langle$  4  $\rangle$  NOT USED.
- 5 EXISTING BRICK PAVERS TO REMAIN
- 6 20X30 CHALKBOARD SUPPLIED BY NAUTICAL, INSTALLED BY G.C.
- $\langle 7 \rangle$  PAINTED MURAL OVER EXISTING BRICK. FIRST WATCH TO PROVIDE GRAPHIC FOR  $\langle 7 \rangle$ REPLICATION TO MURALIST



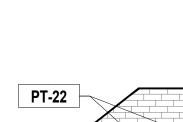

NOT USED

A107 SCALE: 1" = 1'-0"

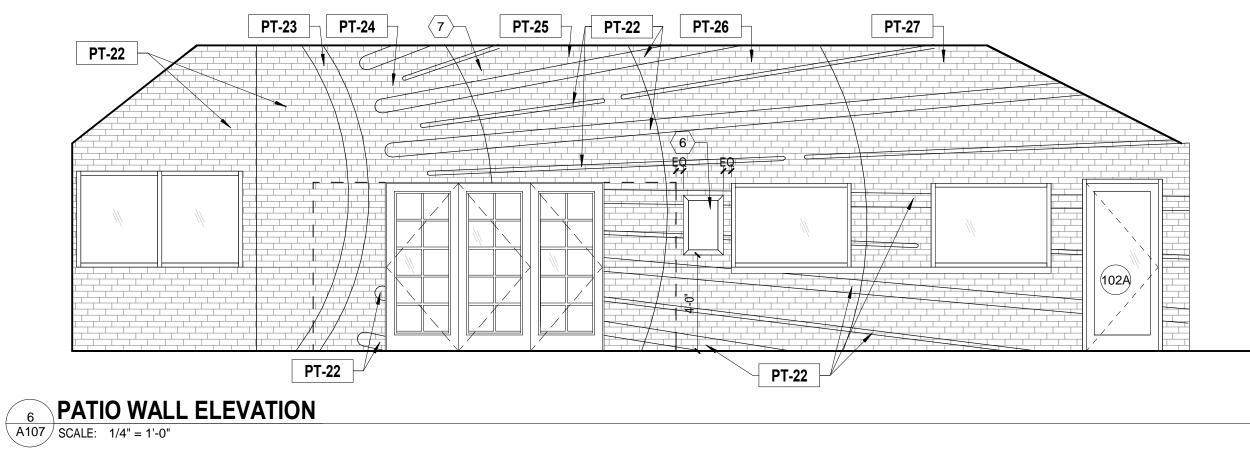




NOT USED

A107 | SCALE: 1" = 1'-0"



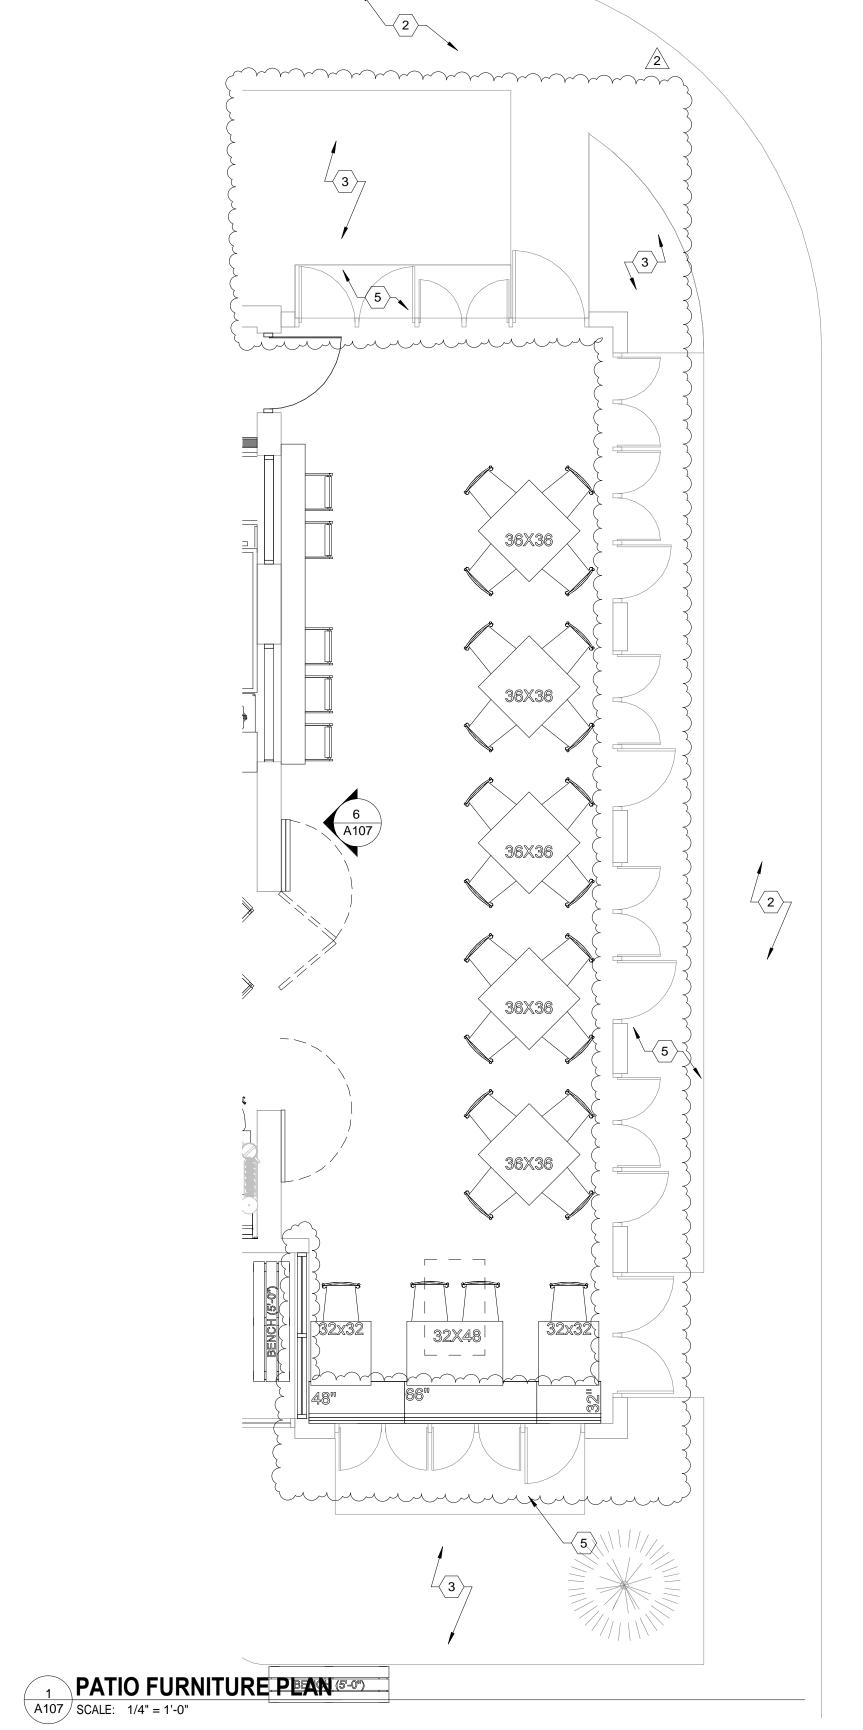

NOT USED A107 | SCALE: 1" = 1'-0"

A107

**PATIO PLAN** 

AND DETAILS

FIRST WATCH

SAWMILL

DUBLIN, OH

DATE ISSUED

P: 859.261.5400 F: 859.261.5530 www.agi-us.com

designing where you want to go.

LATE OF ON

This drawing is the property of ARCHITECTURAL GROUP INT'L and is not to be reproduced or copied in whole or in part. It is only to be used for the project and

site specifically identified herein and is not to be used on any other project. It is to be returned upon request. Scales as stated herein are valid on the original drawing only. Contractor shall carefully review all dimensions and conditions shown herein and at once report to the Architect any error, inconsistency or omission he may

04/07/2022 MN

04/25/2022 MN

2 06/02/2022 MBE OWNER

BY DESCRIPTION


CHANGES


Revisions:

PLANNING APPROVAL

ISSUED FOR BID/PERMIT

NO. DATE

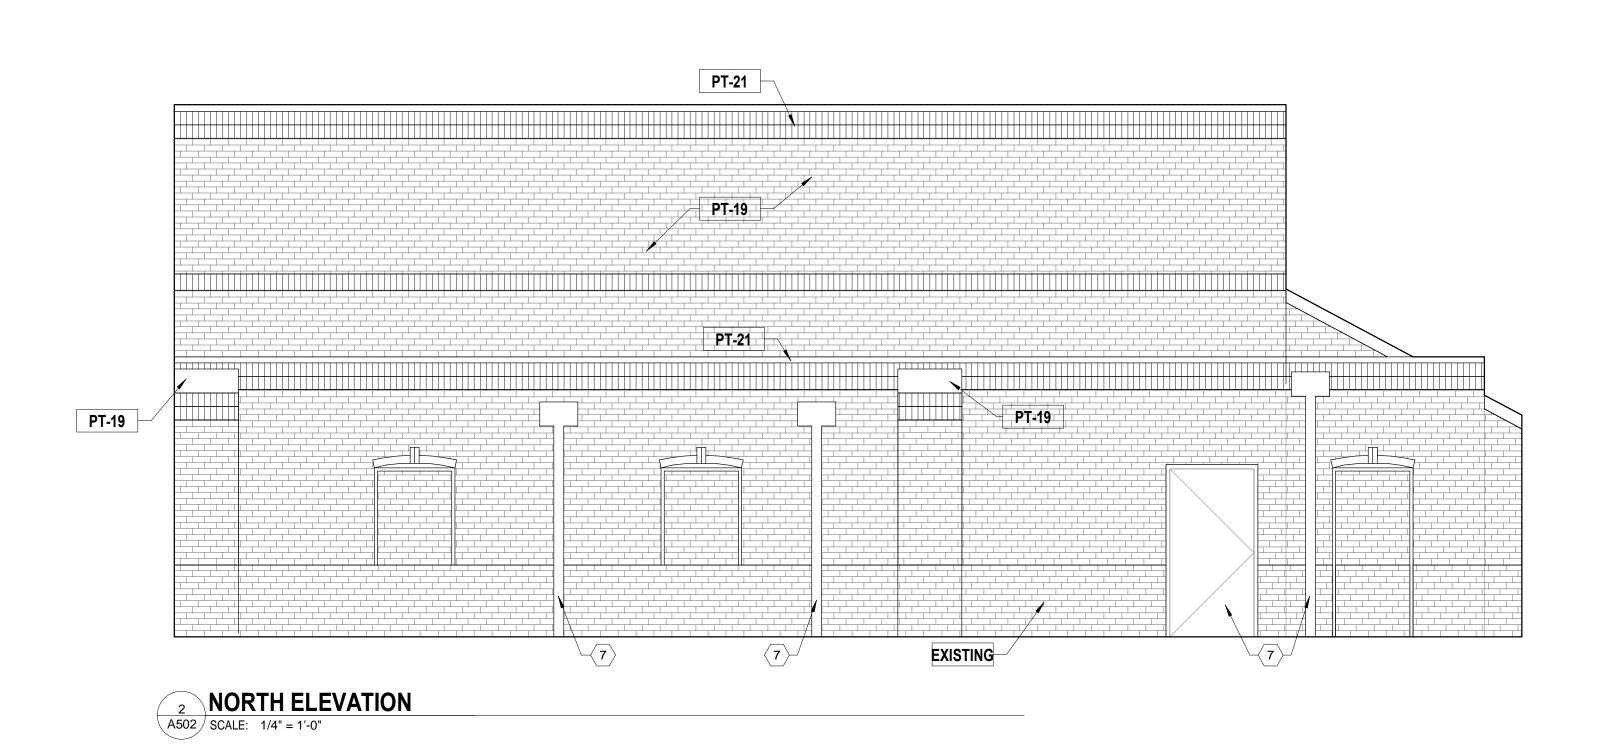

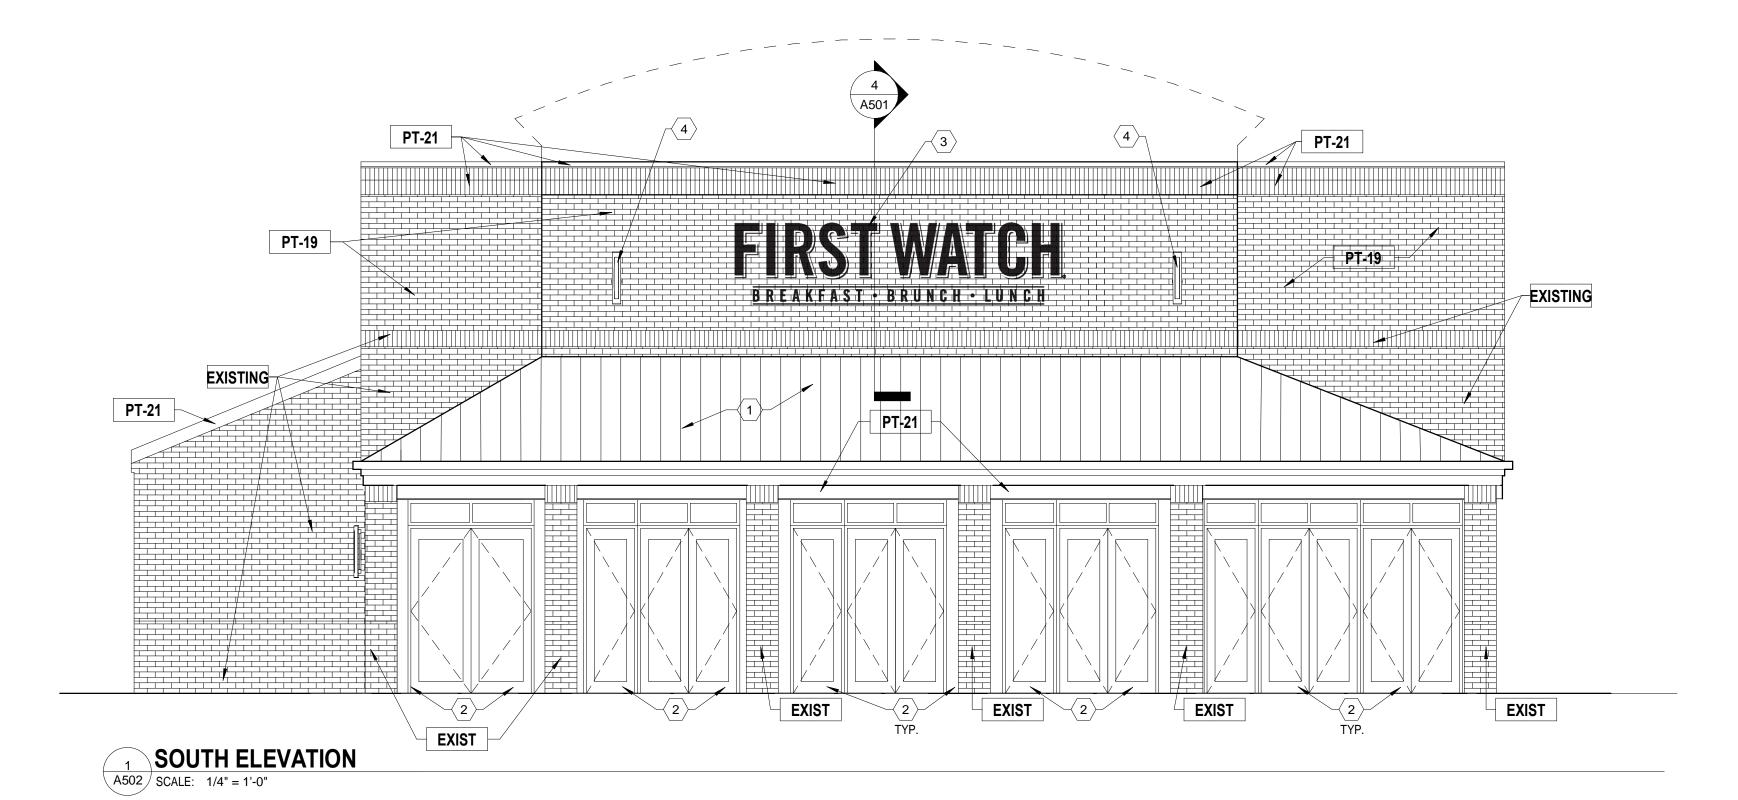

### **GENERAL NOTES**

- 1. ALL MATERIALS MUST BE INSTALLED TO FIRST WATCH SPECIFICATIONS AND STANDARDS. ANY ITEMS NOT INSTALLED TO FIRST WATCH STANDARDS WILL BE REPLACED BY THE CONTRACTOR AT NO COST TO FIRST WATCH.
- 2. G.C. TO PAINT ALL EXTERIOR STOREFRONT FRAMING PT-21.

### **KEYED NOTES**

- 1 EXISTING ROOF TO BE REPLACED WITH METAL SEAM ROOF- BERRIDGE TEE-PANEL IN MATTE BLACK.
- 2 EXISTING PATIO DOOR/WINDOW FRAMES AND STILES TO BE PAINTED PT-21.
- $\langle$  3  $\rangle$  SIGNAGE BY SIGN VENDOR. SIGNAGE UNDER SEPARATE PERMIT.
- $raket{4}$  NEW TROY SLOPE SCONCES TO REPLACE EXISTING SCONCES.
- $\langle 5 \rangle$  NOT USED.
- 6 NEW WINDOWS IN PREVIOUS OPENINGS.
- PAINT ALL WINDOW & DOOR FRAMES AND DOWNSPOUTS PT-21 OR REPLACE TO MATCH PT-21. COORDINATE WITH FIRST WATCH REPRESENTATIVE.


EXTER	RIOR FIN	ISH SPECIFIC	CATIONS
DESIGNATION	DESCRIPTION	COLOR	NOTES
PT-19	EXTERIOR PAINT	SW 7636 ORIGAMI WHITE	
PT-21	EXTERIOR PAINT	SW 7069 IRON ORE	
WP-14	REALSTONE SYSTEMS	ANTIQUE WOOD BARNWOOD PANEL	INSTALL PER MANUFACTURER'S INSTRUCTIONS. USE CORNER SCHLUTER IN SATIN NICKEL ANODIZED ALUMI. INSTEAD OF CORNER PANELS. COORDINATE WITH FIRST WATCH REPRESENTATIVE

LIGHT	FIXTURI	ELEGEND	
SYMBOL	DESCRIPTION	FINISH	NOTES
	26" TROY SLOPE SCONCE EXTERIOR LIGHT	FORGED IRON	





This drawing is the property of ARCHITECTURAL GROUP INT'L and is not to be reproduced or copied in whole or in part. It is only to be used for the project and site specifically identified herein and is not to be used on any other project. It is to be returned upon request. Scales as stated herein are valid on the original drawing only. Contractor shall carefully review all dimensions and conditions shown herein and at once report to the Architect any error, inconsistency or omission he may discover.

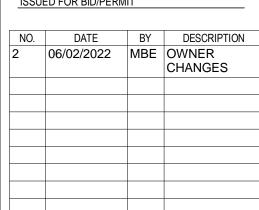





# FIRST WATCH SAWMILL

DUBLIN, OH

PROJECT #
DATE ISSUED

EXTERIOR ELEVATIONS AND DETAILS

$\uparrow$	
Calculation Points	RAL PHOTOMETRIC PLAN NOTES  REPORT: THIS PHOTOMETRIC REPORT REPRESENTS ILLUMINATION ILLATED FROM LABORATORY DATA (IES FILES). THIS LABORATORY I UNDER CONTROLLED CONDITIONS IN ACCORDANCE WITH THE ENGINEERING SOCIETY OF NORTH AMERICA (IESNA) APPROVED TUAL PERFORMANCE OF ANY MANUFACTURER'S LUMINAIRES MAY HAT DUE TO VARIATION IN ELECTRICAL VOLTAGE, TOLERANCE IN THER VARIABLE FIELD CONDITIONS.  LEVELS: THE ILLUMINATION LEVELS SHOWN, MEASURED IN SARE BASED ON THE SPECIFIED CRITERIA. ANY SOPEVIATIONS IN LUMINAIRES OR MOUNTING HEIGHTS, OR TO THE LAYOUT, WILL AFFECT ILLUMINATION LEVELS SHOWN AND HE RESPONSIBILITY OF KLH ENGINEERS.  SIFRED TO ELIMINATE LIGHT TRESPASS OR GLARE ONTO ADJACENT IND/OR ROADWAYS.  HEDULE: REFER TO LUMINAIRE SCHEDULE FOR LUMINAIRE AND POLE THE LUMINAIRE SCHEDULE INCLUDED ON THIS SHEET IS FOR REVIEW REFERENCE ONLY.  TRIBUTIONS: CONTRIBUTIONS FROM ADJACENT STREET LIGHTING, OPERATE ONLY INTRIBUTIONS: CONTRIBUTIONS FROM ADJACENT STREET LIGHTING, OPERATE ONLY INTRIBUTIONS ON THE SHEET IS FOR SHEVIEW REFERENCE ONLY.  TREDITES, AND BUILDING OR POLE MOUNTED LUMINAIRES NOT WITHIN SCOPE ARE NOT REFLECTED IN THIS PHOTOMETRIC REPORT.  ON SPECIFIED MOUNTING HEIGHT FOR POLE-MOUNTED FIXTURES.
●0.2 ●0.3 ●0.3 ●0.3 ●0.3 ●0.3 ●0.3 ●0.2 ●0.1 ●0.1 ●0.1 ●0.1 ●0.1 ●0.2 ● 0.2 ●0.2 ●0.2 ●0.2 ●0.2 ●0.2 ●0.	$-N(C) + \sqrt{1-C}$
	S6 NO RESULTS DUE TO CANOPY ROOF
	NO RESULTS DUE TO CANOPY ROOF  S6
0.2 • 0.2 • 0.1 • 0. • 0.1 • 0.1 • 0.1 • 0.2 • 0.2 • 0.2 • 0.3 • 0.3 • 0.4 • 0.4 • 0.4 • 0.5 • 0.6 • 0.9 • 1.6 • 3.1 • 0.8 • 2.4 • 1.8 • 2.8 • 0.2 • 0.2 • 0.2 • 0.1 • 0.1 • 0.1 • 0.1 • 0.2 • 0.2 • 0.2 • 0.3 • 0.3 • 0.4 • 0.4 • 0.4 • 0.4 • 0.5 • 0.6 • 0.9 • 1.6 • 3.1 • 3.1 • 2.4 • 1.7 • 1.8 • 1.8 • 1	1.8 • 3.1 • 2.6 • 3.5 • 2.2
ELECTRIC PHOTOMETRIC PLAN 1/4" = 1'-0"	




ARCHITECTURAL GROUP INTERNATIONAL

15 West Seventh Street, Covington, KY 41011
P: 859.261.5400 F: 859.261.5530

www.agi-us.com

designing where you want to go.

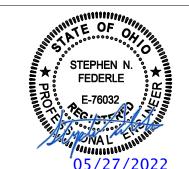



1538 ALEXANDRIA PIKE, SUITE 11 FT. THOMAS, KENTUCKY 41075 800-354-9783 859-442-8050 859-442-8058 FAX

This drawing is the property of ARCHITECTURAL GROUP INT'L and is not to be reproduced or copied in whole or in part. It is only to be used for the project and site specifically identified herin and is not to be used on any other project. It is to be returned upon request.

Scales as stated hereon are valid on the original drawing only. Contractor shall carefully review all dimensions and conditions shown hereon and at once report to the Architect any error, inconsistancy or omission he may discover.

#### Revisions:

		_	
NO.	DATE	BY	DESCRIPTION
NO.	DATE 05/26/22	BY	DESCRIPTION Rev 2- Owner Changes
NO.		BY	
NO.		BY	

FIRST WATCH THE DAYTIME CAFI



FIRST WATCH SAWMILL

DUBLIN, OH

oject No. 21092 H Project No. 24126 ue Date 5/26/20

ELECTRICAL PHOTOMETRICS

Sheet

E111