


18-21497
ENGINEERING COMPLIANCE
City of Dublin
APPROVED AS NOTED
CG 9/10/18

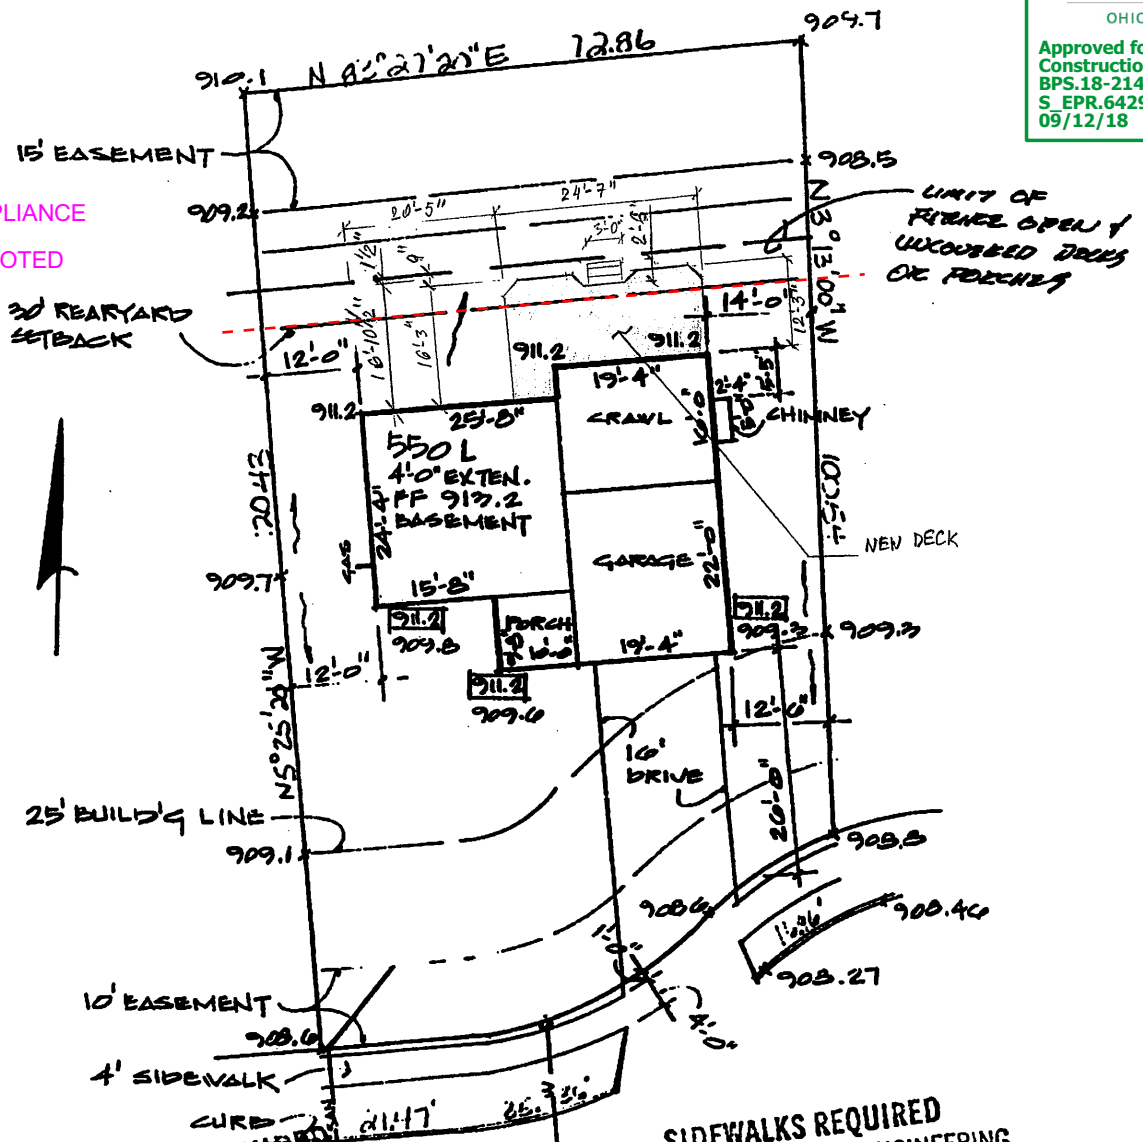

STREET TREES REQUIRED
Contact Paula Chope, Urban Forester
To Coordinate - 761-6520

SIDEWALKS REQUIRED
CONTACT GARRY CLARK, ENGINEERING
TO COORDINATE 761-6550

RICHGROVE LANE

ENGINEERING COMPLIANCE
APPROVED AS NOTED
City Of Dublin, Ohio *shelley*

BUILDING CO. <u>DAVIDSON-PHILLIPS, INC</u>	SCALE: <u>1" = 20'</u>
LOT NO. <u>30</u>	SUBDIVISION <u>BRIGHTON PARK</u>
STREET ADDRESS <u>5692 RICHGROVE LANE</u>	DRAWN <u>1-12-94</u> SHT. NO. <u>1/1</u>