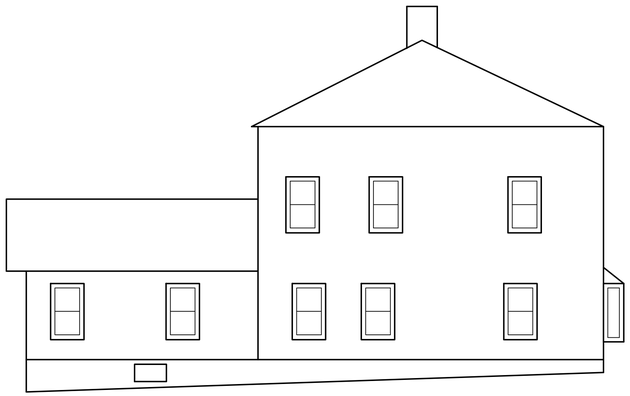

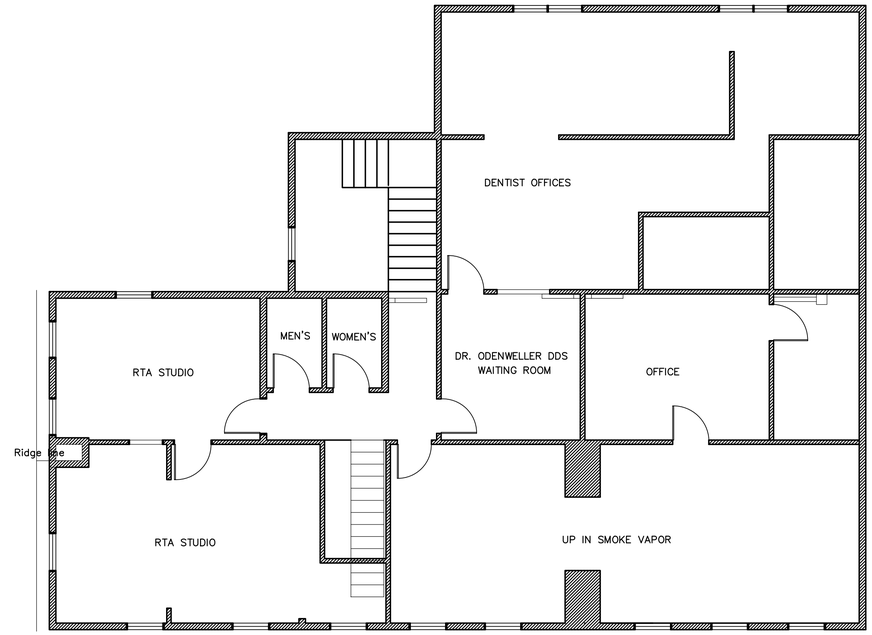

2 A1-1 **SECOND FLOOR PLAN**
SCALE: 3/16" = 1'-0"

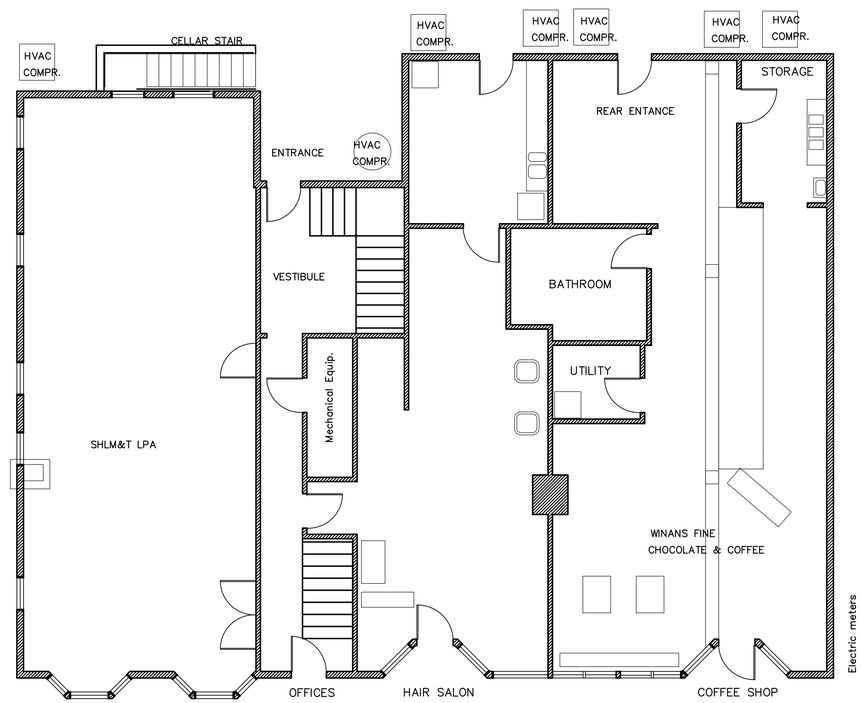

1 A1-1 **FIRST FLOOR PLAN**
SCALE: 3/16" = 1'-0"

project title

Alterations for
48-52 S. High
Street, Dublin OH.

for

Bob Deuberry & John Leff
1601 W. fifth Avenue
COLUMBUS, OHIO 43212

Floor Plans
48-52 South High St.
Dublin, OH

COPYRIGHT
THIS DRAWING AND DESIGN REPRESENT THE UNPUBLISHED WORK OF A. PETER LENZ, AIA ARCHITECT. REPRODUCTION OR RE-USE OF ANY PART OF THESE DRAWINGS WITHOUT WRITTEN PERMISSION BY THE ARCHITECT IS AGAINST THE COMMON LAW COPYRIGHT.

A. PETER LENZ, AIA
ARCHITECT
515 Hartford Street
Worthington, Ohio 43085
614-840-0844 voice
614-301-6166 cell
Architecture Space Planning

seal

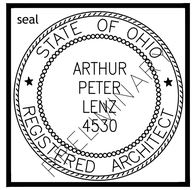

date		revisions
06	12	As-Built set

project number
06-014

sheet number
A1-2

date June 19, 2014